


KANSAS

Section 4 Township 1 Range 18W

Well No. #1 Kauk

Company Alpine Oil & Royalty

NORTH

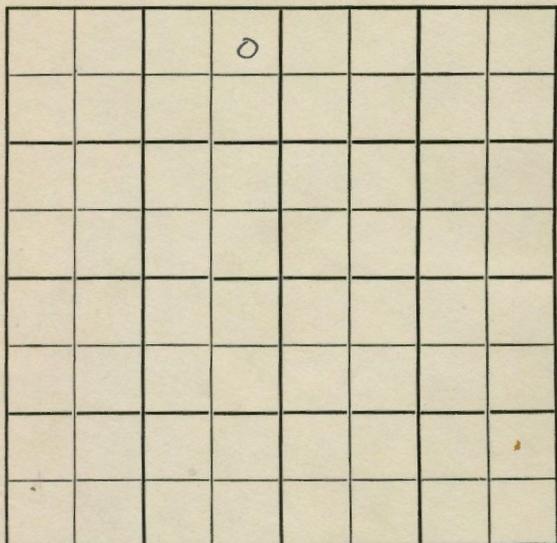

SOUTH

3

Phillips

KANSAS

Sec. 4 Twp. 1 R. 18W

Well No. #1 Kauk Farm

Alpine Oil & Royalty Company

Quaker Drlg. - Contr. Contractor

Fischer Pool

330' Ft. from N. Line


..... Ft. from S. Line

330' Ft. from E. Line

..... Ft. from W. Line

NE NE NW

NORTH

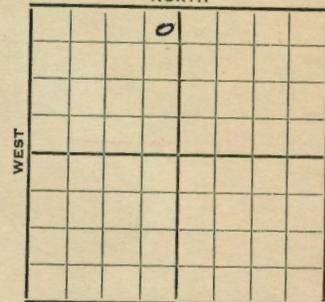

SOUTH

1951 **Elev. 2032'** REPORT

- 12/12 RUR
- 1952
- 2/6 Drlg. 3460'
5" @ 3460' WOCT
Heeb. 3213 Lans. 3239
- 2/13 No report
- 2/20 "
- 3/5 "
- 3/12 CO to 3457' 48/3404-14
Fill up 1000' oil. 1000 A
- 3/19 S/2 Boph for 6 hrs.
PB 3320 24/3326-32 NS
16/3332-34 NS 32/3337-41
24/3308-14 NS 8/3314-16 NS
1000 A NS DP to 3457 POP
- 3/25 "
- 4/1 POP
- 4/9 NR
- 4/23 NR
- 4/30 "
- 5/7 "
- 5/13 "
- 5/21 "
- 5/28 "
- 6/11 "

OVER

1952
6/18 NR
6/25 NR
7/2 "
7/9 "
7/17 "
7/23 "
7/30 18 BOPD
8/6 NR
8/13 "
8/20 "
8/27 "
9/3 "
9/10 "
9/17 "
9/24 "

10/1 "
10/8 Spud 2-11-52
Oil Well TD 3460'
8" @ 165

Heeb. 3213 Lans. 3239
TD 3460 5" @ 3460' CO to 3457
48/ 3404-14 FU 1000' oil
1000 A S/ 2 boph FB 3370
24/ 3326-32 16/3332-34
32/ 3337-41 24/ 3308-14
8/ 3314-16 1000 A DP 3457
Comp. 15 bopd 10% wtr.

COMPLETED

