


Section 6 Township 1 Range 18W

Well No. #1 Farley

Company Honeker Drlg.

NORTH

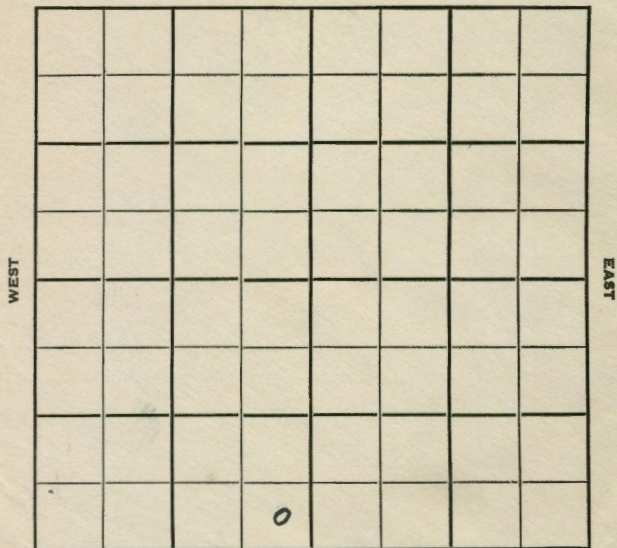

SOUTH

14

Sec. 6 Twp. 1 R. 18 W ✓

Well No. #1 Farley Farm

Honeker Drlg. Company

Contractor

Dry Creek Pool

Ft. from N. Line


330 Ft. from S. Line

330 Ft. from E. Line

Ft. from W. Line

SE SE SW

NORTH

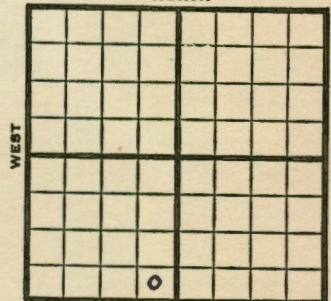

SOUTH

1951 **Elev. 2037'** REPORT

3/21  
4/18

MIR  
 Spud 3-18-51  
 D & A TD 3410'  
 8" @ 223, 5" @ 3410  
**KC 3296'**, TD 3410'  
 16/3371-76, 500 A 40/3352-62  
 500 A B/126 GW 26 GOPH SP 3328  
 16/3320-24, 17/3284-89, 500 A  
 12 GO 82 BWPB  
 D & A.

**ABANDONED**

