


Section 7 Township 1 Range 18-W

Well No. #1 Gebhart

Company Honaker Drlg.

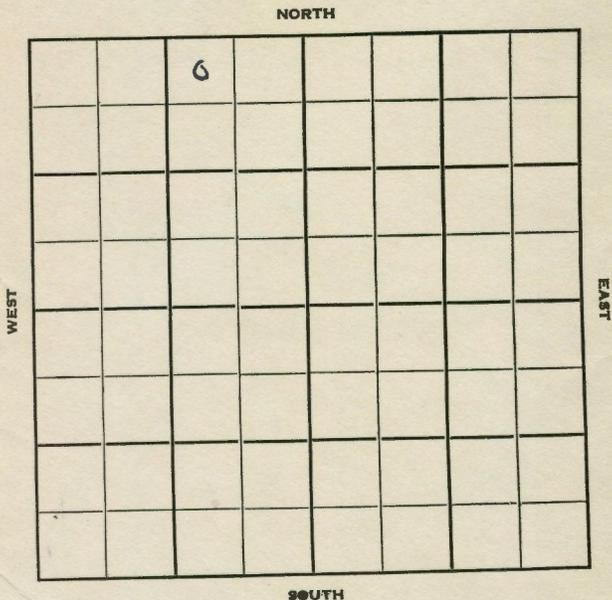

SOUTH

3

Sec. 7 Twp. 1 R. 18W ✓

Well No. #1 Gebbart Farm _____

Honaker Drlg. Company _____

Wildcat Contractor _____


330' Ft. from N. Line

_____ Ft. from S. Line

990' Ft. from E. Line

_____ Ft. from W. Line

NW NE W

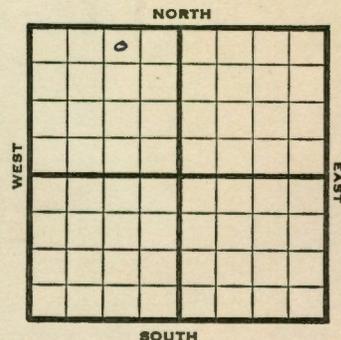

1950 **Elev. 2085'** REPORT

11/29 Spud 11-25-50
8-5/8" @ 164'
Drlg. 1604'

3/21 Spud 11-25-50
Oil Well TD 3449
8-5/8" @ 164'
Lans. 3315' TD 3449
5" @ 3447' 23/3428-33 500 A
B/1 pt. oil PB 3425
16/3420-23 B/5 gw 3/4 gal.
oil in 20 min. 500 A B/ 3/4 go
2 gw 3000 A no inc. PB 3417
36/3408-14 B/15 go 9 gw 500 A
S/40 bfph GO to 3423 30/3408-12
tr. oil 500 A B/6 boph
Comp. 6 Bopd 54% wtr

COMPLETED

County Phillips State Kansas
 Sec. 7 (Blk. 1 (Sur. 18W Map No.
 (Twp.) (Rge.)
 Operator Honaker Drlg.
 Well No. 1 Farm Gebhart
 Elev. Location NW NE NW

0			

330 Ft. From N Line NW
990 Ft. From E Line Quarter
 Ist. Report NOV 29 1950
 Completion _____
 Remarks _____
Honaker Drlg. - Contr.
 Spudding Date 11-25-50

Drlg. Data Wildcat
8 5/8" @ 164 drlg. 1604

J. E. TYRA

County Phillips State Kansas
 Sec. 7 (Blk. 1 (Sur. 18W Map No.
 (Twp.) (Rge.)
 Operator Honaker Drlg.
 Well No. 1 Farm Gebhart
 Elev. 2085 Location NW NE NW

0			

330 Ft. From N Line NW
990 Ft. From E Line Quarter
 Ist. Report _____
 Completion MAR 21 1951
 Remarks Wildcat
Honaker Drlg. - Contr.
 Spudding Date 11-25-50

Drlg. Data Oil well TD 3449
8 5/8" @ 164 Lans. 3315 TD 3449
5" @ 3447 23/ 3428-33 500 A B/ 1 pt.
oil PB 3425 16/ 3420-23 B/ 5 gw
3/4 gal. oil in 20 min. 500 A B/ 3/4 go
2 gw 3000 A no inc. PB 3417
36/ 3408-14 B/ 15 go 9 gw 500 A
S/ 40 bfph CO to 3423 30/ 3408-12
tr. oil 500 A B/ 6 boph
Comp. 6 bopd 54% water

J. E. TYRA