


Phillips **KANSAS**

Section 7 Township 1 Range 18W

Well No. #1 Hector

Company Honaker Drlg.

NORTH

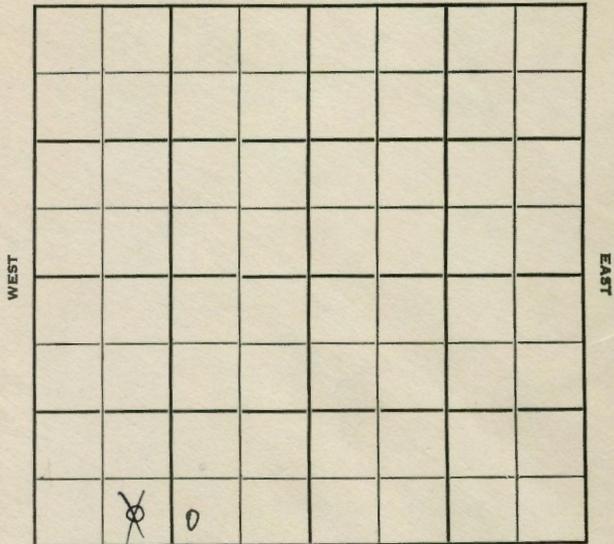

SOUTH

14

Phillips

KANSAS

Sec. 7 Twp. 1 R. 18W

Well No. #1 Hector Farm

Honaker Drlg. Company

Honaker Drlg. - Contr. Contractor

Wildcat

 Ft. from N. Line


330' Ft. from S. Line

850' Ft. from E. Line

990' 1650' Ft. from W. Line

SW SE
SE SW SW

NORTH

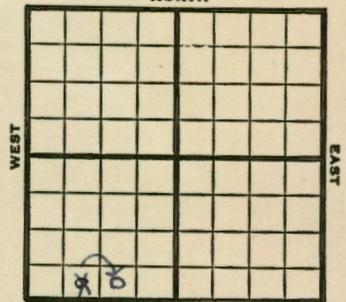

SOUTH

1950

Elev. 2141

REPORT

12/20
1451
1/31

RUR

Spud 12/18/50
D & A TD 3490
8" @140

Heeb. 3331 Lans 3356
TD 3490

5" @3489 CO to 3428
12/3446-50 S/ 60 gwph SP 3428
32/3421-26 B/2 goph 500 A FU 2313'
water SP 2414 22/ 3404-07 500 A
HFW D & A

ABANDONED

Kansas

Map No. _____ Sec. 7 Twp. 1 R. 18W

Well No. 1 Hector

Honaker Drlg. Company

CORRECTION Contractor

SW SE SW

SECTION PLAT

_____ Ft. from N. Line

330 Ft. from S. Line

850 Ft. from E. Line

1650 Ft. from W. Line

Normal section

Phillips County

Location _____

Rig up _____

Drilling and Remarks:

Reported

SE SW SW

RECORD

Cased _____ in., _____ ft.

Sand _____

Gas _____

Oil _____

Total Depth _____

PRODUCTION

1st 24 hrs. Nat. _____

1st 24 hrs. after shot _____

Gas _____ Cu. Ft.

Dry Hole _____

Abandoned _____

Date

DEC 27 1950 19

J. E. TYRA Scout