


Phillips

KANSAS

Section 9 Township 1 Range 18 W
 Well No. # 1 Seyler
 Company Lewis Drlg.

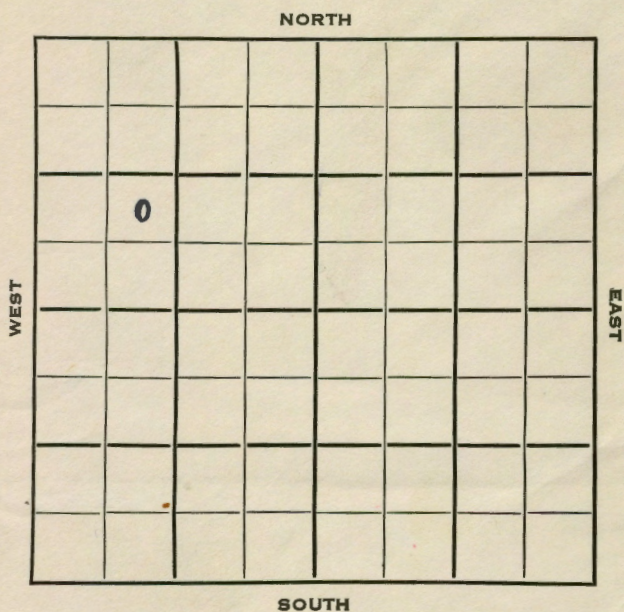


5

Phillips

KANSAS ✓

Sec. 9 Twp. 1 R. 18W
 Well No. #1 Seyler Farm _____
Lewis Drlg. Company _____
Lewis Drlg. Contractor _____
Wildcat

_____ Ft. from N. Line
990 _____ Ft. from S. Line
 _____ Ft. from E. Line
990 _____ Ft. from W. Line
 NE SW NW

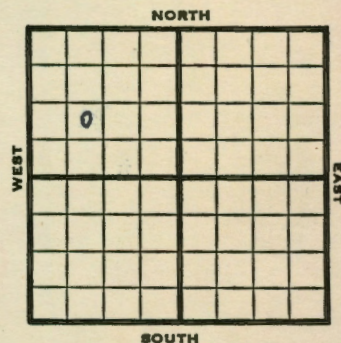

1952 **Elev. 2139'** REPORT

12/3 Location

12/11 Heeb 3309 Ø3490

12/17 Spud 12-3-52

D&A

TD 3525

8" @ 141

Heeb 3309, Tor 3339, Lans. 3360

TD 3525

D&A

ABANDONED

County	Phillips			State	Kansas
Sec.	9	(Bk. Twp.)	1	(Sur. Rge.)	18W Map No.

Operator Lewis Drlg.

Well No. 1 Farm Seyler

Elev.	2139	Location	NE SW NW
-------	------	----------	----------

990 Ft. From S Line NW

990 Ft. From W Line Quarter

1st. Report

Completion DEC 17 1959

Remarks Wildcat

Lewis Drlg. - Contr.

Spudding Date 12-3-52

Drig. Data D & A TD 3525

8" @ 141 Heeb. 3309 Tor. 3339

Lans. 3360 TD 3525

D & A

J. G. McGEHEE

County	Phillips		State	Kansas
Sec.	8	(Bk. Twp.)	1	(Sur. Rce.)
			18W	Map No.

Operator Lewis Delg.

Well No. 1 Farm Seyler

Elev.	Location	NE	SW	NW
-------	----------	----	----	----

990 Ft. From 8 Line NW

990 Ft. From W Line Quarter

1st. Report DEC 3 1952

Completion

Remarks

Lewis Drlg. - Contr.

Spudding Date

Drlg. Data

Wildcat

Location

J. G. McGEHEE