


Phillips

KANSAS

SECTION 20 TOWNSHIP 1 RANGE 18W

WELL NO. #1 Hageman "B"

COMPANY Livingston Oil

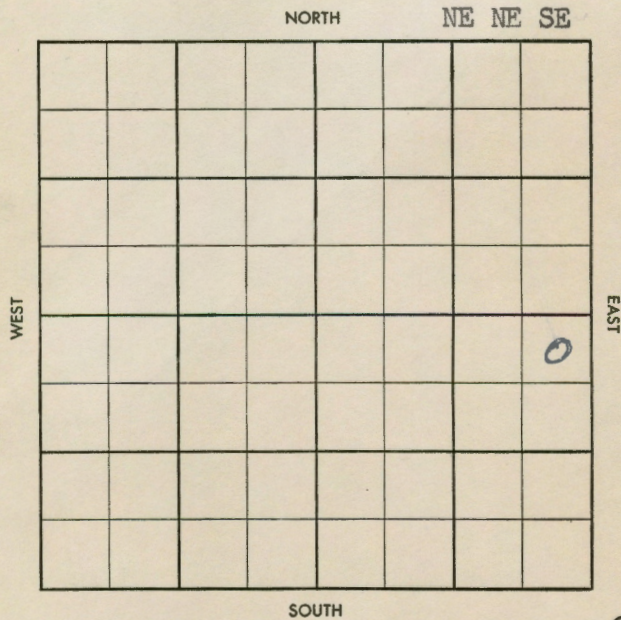

9

