


Section 21 Township 1 Range 18W

Well No. #3 Stephens

Company National Assoc. Pet.

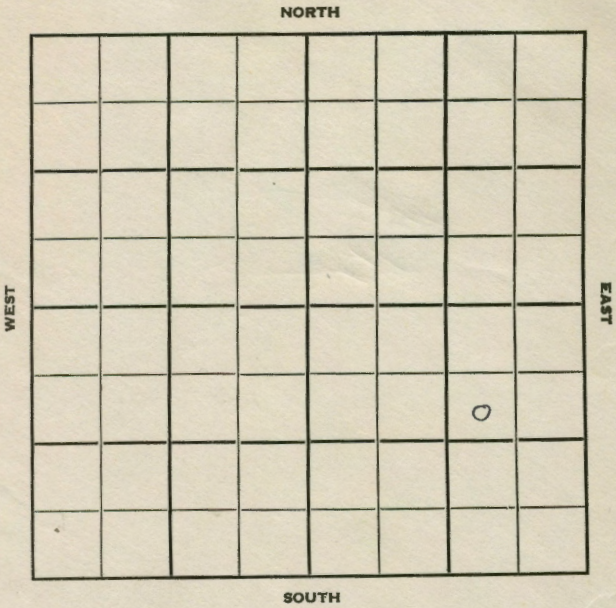

9

PHILLIPS
FORM 11-50 PETROL

Sec. 21 Twp. 1 R. 18 W

Well No. # 3 Stephens Farm

National Assoc. Pet. Company

K & E Drlg. Contractor

Stephens Pool


990 Ft. from N. Line

_____ Ft. from S. Line

990 Ft. from E. Line

_____ Ft. from W. Line

SW NE SE

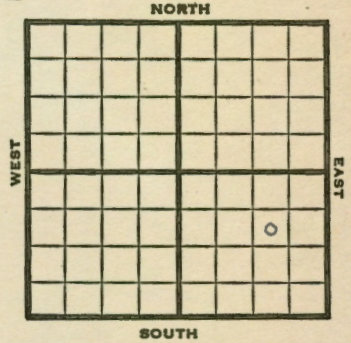

1951	Elev. 2195'	REPORT
9/5	Drilling	
11/21	Spud 9-3-51	
	Oil well TD 3531' 8" @ 202	
	Anhy 1770' Heeb 3352' Lans. 3380'	
	TD 3531' 5" @ 3530 42/3442-35	
	1000 A 3/4 BOPH 2000 A 1 1/2 BOPH	
	17/3455-59 14/3463-66 9/3482-84	
	1000 A S/2 BOPH 3000 A	
	S/3-3/4 BOPH	
	Comp. 103 BOPD	
	COMPLETED	

