


Phillips

KANSAS

SECTION 22 TOWNSHIP 1S RANGE 18W

WELL NO. #2 Kent

COMPANY Livingston Oil

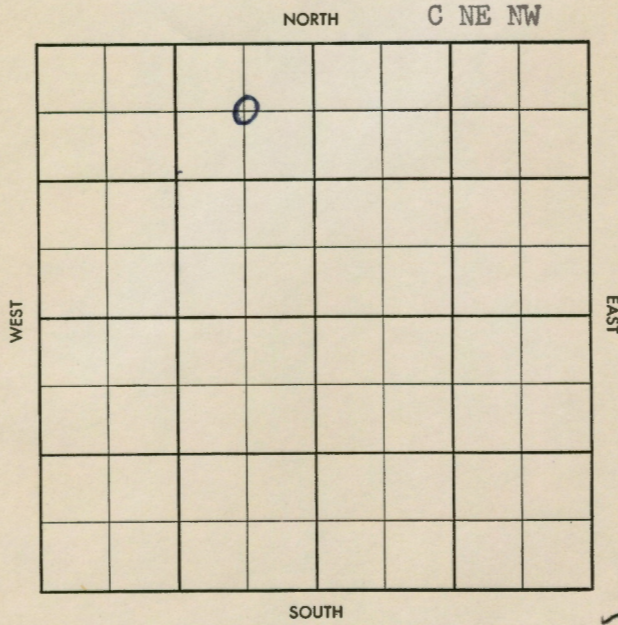

3

