


KANSAS

SECTION 22 TOWNSHIP 1 RANGE 18W
WELL NO. STEVENS "A"
#1 Stephens
COMPANY Livingston Oil

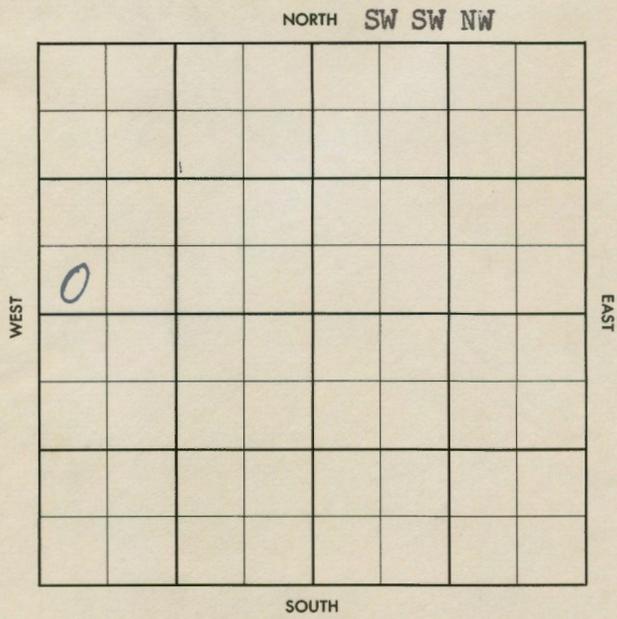

5

CORRECTION

FORM 913 SUNRAY

2129

County Phillips Elev. 3143 KB
 Sec. 22 Twp. 1 Rge. 18W
 Company Livingston Oil
 Farm Name Stevens Stephens "A" No. 1

TOPS	DEPTH	LOG	DATUM	Loc. in Sec.
Am		3062		SW SW NW
Tr		3278		
Bl		3310		
L.C.		3326		Geol. <u>Arkenman</u>
Co.				Contr. <u>Wakefield</u>
C.				
M.				Pool <u>Huffstutter</u>
R.				
Mz.				
Ma.				
V.				
S.				
E.				
A.				
R.				
PC				
G.				
TA	3467	3467		

FEB 19 '58
 COMPLETE

Date Comm. 9-6-57
 8" @ 165 drlg. 2670 SEP 18 57 TIGHT
 will be oil well SEP 25 57 OCT 2 57
 OCT 9 57 OCT 16 57 OCT 23 57 OCT 30 57
 may plug NOV 6 57 RUC NOV 13 57
 NOV 20 57 NOV 27 57 DEC 4 57 pumping DEC 11 57
 DEC 18 57 DEC 26 57 JAN 8 58
 JAN 15 58 58 JAN 29 58 FEB 5 58 FEB 12 58
 FEB 19 58

FORM 813-1 SUNRAY

DST 3345-70 open 1 1/2 hr. rec. 150' vho cm
 770/30" DST 3367-92 open 1 1/2 hr.
 rec. 15' smco 30' socm 670/30"
 DST 3389-3410 open 1 hr. rec. 21' hocm
 60' socm 800/30" DST 3410-35 open 1 1/2 hr
 rec. 5' ocm 90' vho cm 930/30"
 7" @ 3466 CO 16/ 3413-17 B/ 50
 16/ 3398-3402 B/ 3 go 12/ 3376-79
 B/ 1 bo 16/ 3413-17 1500 A
 Channel csg. collapsed drilled new hole
 outside of pipe from 3325-3450 4 1/2" @ 3131-
 3450 CO 16/ 3413-17 1500 A
 16/ 3398-02 1500 A 16/ 3376-80
 1500 A 16/ 3358-62 1500 A S/ load
 ROP P/ 25 bopd 11-20-57 FEB 12 58 FEB 19 58

P 25 Bopd NW

P 25 Bopd NW

22-1-18W

sw sw nw

