


Section 21 Township 1 Range 18W

Well No. #2 ~~#1~~ Stephens

Company National Assoc. Pet.

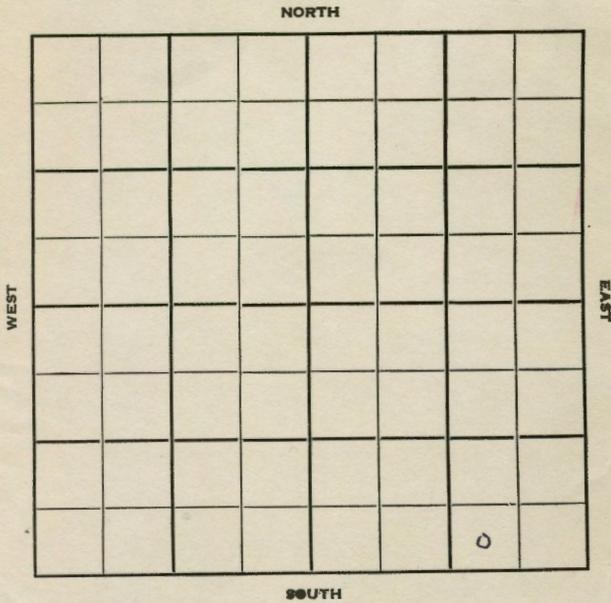

16

Sec. 21 Twp. 1 R. 18 W

Well No. #5 Stephens Farm

National Assoc. Pet. Company


K & E Drlg. Contractor

\_\_\_\_\_ Ft. from N. Line

330 Ft. from S. Line

990 Ft. from E. Line

\_\_\_\_\_ Ft. from W. Line

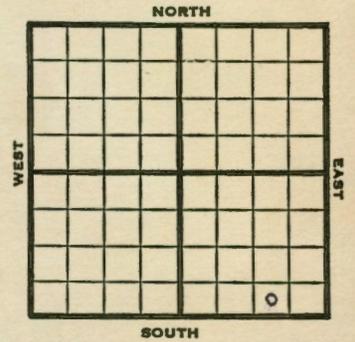

SW SE SE

K&E Drlg. Contr.

1951 **Elev. 2143'** REPORT

8/8 Cellar & Pits  
 10/24 Oil Well TD 3479  
 8" @ 202'  
**Anhy 1710' Lans. 3332-3479'**  
 5" @ 3479 CO to 3444'  
 28/ 3420-27 15 BOPH  
 2000 A S/ 7 BOPH 12 hr.  
 PB 3410 4/ 3403-04  
 20/ 3398-3406 S/ 6 BOPH 8 hr.  
 SP 3390 20/ 3383-88  
 2000 A S/ 11 BOPH  
 CO to 3444' S/ 12 BOPH 2 hr.  
 P/ 8 BOPH 12 hr.  
 Comp. 143 BOPD

**COMPLETED**

