


Section 27 Township 1 Range 18-W

Well No. #2 Babcock

Company B & R Drlg.

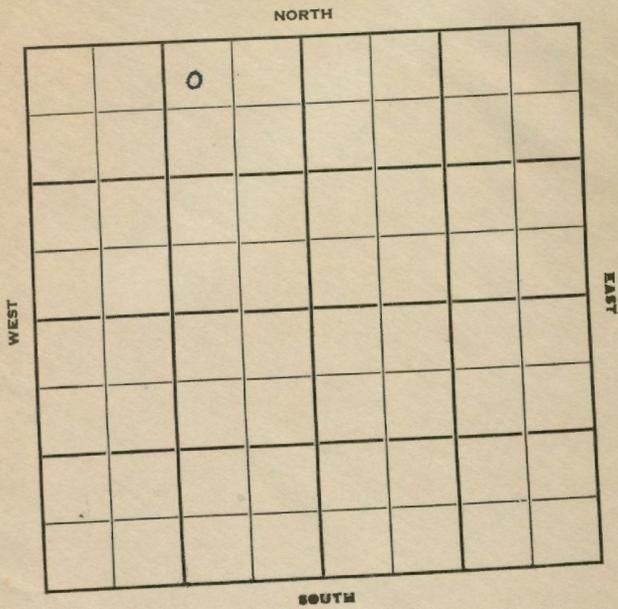

3

Sec. 27 Twp. 1 R. 18W

Well No. #2 Babcock Farm

B & R Drlg. Company

B & R Drlg. Contractor


330' Ft. from N. Line

\_\_\_\_\_ Ft. from S. Line

990' Ft. from E. Line

\_\_\_\_\_ Ft. from W. Line

NW NE NW

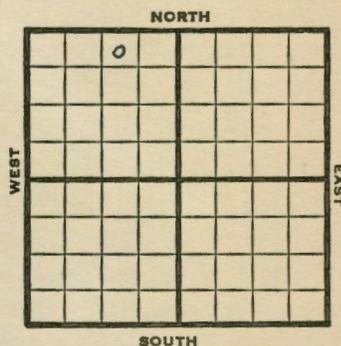

1950 **Elev. 2102'** REPORT

9/6 Spud 9-2-50  
8" @ 210'  
Drlg. 2025'

1951  
4/11 Spud 9-2-50  
Oil well TD 3440'  
8" @ 210 Top. 3042', Heeb 3263',  
Lans 3293', SSO 3293-96', Por 3339-45  
Stain 3356-59', 3365-68', Por 3380-85  
Stain 3393-98',  
TD 3440', 5" @ 3434 24/3428-34  
24/3404-10, 11/3391-94, 12/3359-63  
B/ 1 CW SSO 12/3349-55, 11/3340-44  
9/ 3357-59, 2000 A SP 3324  
24/ 3311-19, B/ 1/2 GFPH 500 A  
SP 3300, 12/3273-77, B/12 GFPH  
500 A CO to 3371' S/1 BFPH  
Est. 1/2 BO  
Comp. 2 BOPD 15 BW

**COMPLETED**

County Phillips State Kansas  
 Sec. 27 (Blk. 1 (Sur. 18W (Twp.) 1 (Rge.) Map No.  
 Operator B & R Drlg.  
 Well No. 2 Farm Babcock  
 Elev. 2102 Location NW NE NW

|   |  |  |  |
|---|--|--|--|
| 0 |  |  |  |
|   |  |  |  |
|   |  |  |  |
|   |  |  |  |
|   |  |  |  |
|   |  |  |  |
|   |  |  |  |
|   |  |  |  |

330 Ft. From N Line NW  
990 Ft. From E Line Quarter  
 Ist. Report \_\_\_\_\_  
 Completion APR 11 1951  
 Remarks Wildcat  
B & R Drlg. - Contr.  
 Spudding Date 9-2-50

Drlg. Data Oil well TD 3440  
8" @ 210 Top. 3042 Heeb. 3263 Lans. 3293  
SSO 3293-96 Por. 3339-45  
Stain 3356-59 3365-68 Por. 3380-85  
Stain 3393-98 TD 3440 5" @ 3434  
24/ 3428-34 24/ 3404-10 11/ 3391-94  
12/ 3359-63 B/ 1 gw SSO 12/ 3349-55  
11/ 3340-44 9/ 3357-59 2000 A  
SP 3324 24/ 3311-19 B/ 1/2 gfph 500 A  
SP 3300 12/ 3273-77 B/ 12 gfph 500 A  
CO to 3371 S/ 1 bfph Est. 1/2 bo  
Comp. 2 bopd 15 bw

J. E. TYRA

County Phillips State Kansas  
 Sec. 27 (Blk. 1 (Sur. 18W (Twp.) 1 (Rge.) Map No.  
 Operator B & R Drlg.  
 Well No. 2 Farm Babcock  
 Elev. 2102 Location NW NE NW

|   |  |  |  |
|---|--|--|--|
| 0 |  |  |  |
|   |  |  |  |
|   |  |  |  |
|   |  |  |  |
|   |  |  |  |
|   |  |  |  |
|   |  |  |  |
|   |  |  |  |

330 Ft. From N Line NW  
990 Ft. From E Line Quarter  
 Ist. Report SEP 6 1950  
 Completion \_\_\_\_\_  
 Remarks \_\_\_\_\_  
 Spudding Date 9-2-50

Drlg. Data Wildcat  
8" @ 210 drlg. 2025

J. E. TYRA