


KANSAS

Section 28 Township 1 Range 18 W

Well No. # 1 Jackson "E"

Company National Assoc. Pet.

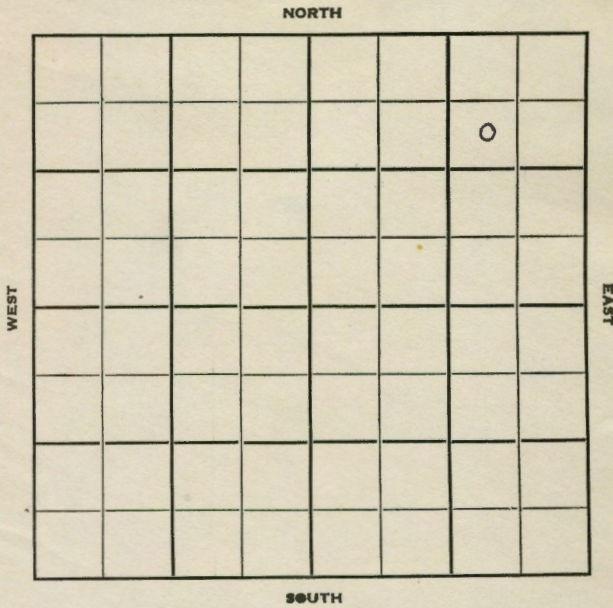

Phillips

KANSAS

Sec. 28 Twp. 1 R. 18W

Well No. #1 Jackson "E" Farm

National Assoc. Pet. Company

Ferrell Drlg. Contractor

Huffstutter Pool


990 Ft. from N. Line

Ft. from S. Line

990 Ft. from E. Line

Ft. from W. Line

SW NE NE

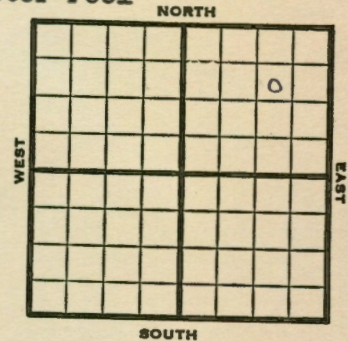

1951 Elev. 2157 REPORT

10/3 Spud 9-29-51
8" @ 191

11/28 Drlg. 1100'
Spud 9-29-51

Oil well TD 3485
8" @ 191

Heeb. 3304 Lans. 3332

DST 3340-96 TD 3485

5" @ 3483 CO to 3460

18/ 3434-37 36/ 3426-32

1000 A S/ 6 BOPH S/ 9 BOPH

PB 3410 12/ 3403-06

24/ 3386-92 1000 A

CO to 3459 Comp. 180 BOPD

COMPLETED

