


Section 26 Township 1 Range 18 WWell No. # 1 HolsmanCompany Harbar et al

NORTH

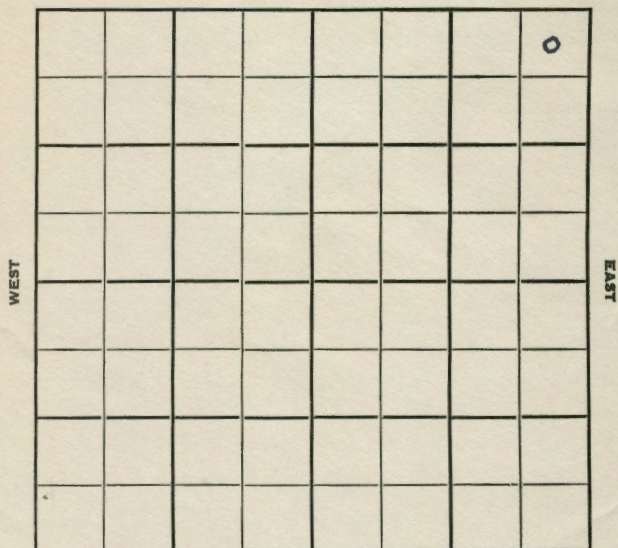


SOUTH

Sec. 26 Twp. 1 R. 18 WWell No. # 1 Holsman FarmHarbar et al CompanyHarbar Drlg. ContractorWildcat
330 Ft. from N. Line Ft. from S. Line330 Ft. from E. Line Ft. from W. Line

NE NE NE

NORTH

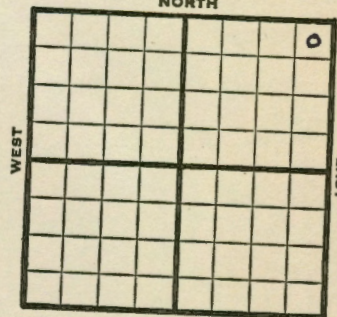

SOUTH

1951

Elev. 2188' REPORT

2/28
3/14

Wildcat

Spud 2-28-51

D&A TD 3675

8" @ 160

Heeb. 3467' Lans. 3497

TD3675 D&A

ABANDONED

J. E. TYRA

R U R

J. E. TYRA