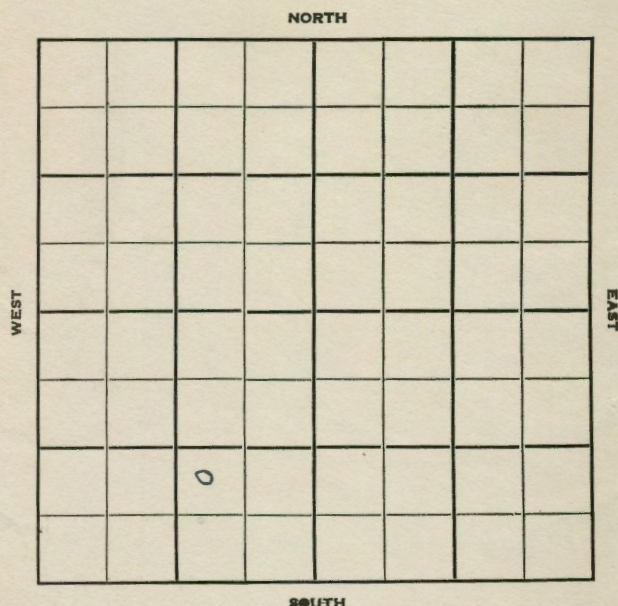


Section 28 Township 1 Range 18WWell No. 1 Jackson "B"Company National Assoc. Pet.

14

Sec. 28 Twp. 1 R. 18 WWell No. # 1 Jackson "B" FarmNational Assoc. Pet. CompanyK & E Drlg. ContractorHuffstutter Pool


Ft. from N. Line

330 Ft. from S. Line990 Ft. from E. Line

Ft. from W. Line

SW SE SW

K&E Drlg. Contr.

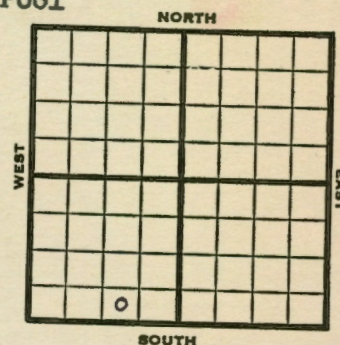
1951 **Elev. 2258'** REPORT

8/1 Spud 7-25-51
10" @ 200'
Anhy 1825'
Drlg. 2829'

10/24 Spud 7-25-51
Oil Well TD 3572
10" @ 200'
Anhy 1825' Lans. 3423'
TD 3572'
5" @ 3570' 20/ 3500-05 1 GOPH
24/ 3572 12 GOPH 10003A00-05
S/ 70 BO 12 hr. PB 3465 24/ 3436-42
5 BOPH 1000 A S/ 4 1/2 BOPH
S/ 19 1/2 BO 2 hr.
Comp. 104 BOPD 15% wtr.

COMPLETED

County Phillips State Kansas
 Sec. 28 (Blk. 1 (Sur. 18W Map No.
 Operator National Assoc. Pet.
 Well No. 1 Farm Jackson "B"
 Elev. 2258 Location SW SE SW

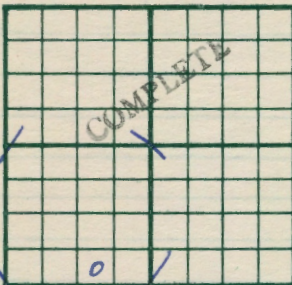

330 Ft. From S Line SW
 990 Ft. From E Line Quarter

1st. Report

Completion OCT 24 1951

Remarks Huffstutter Pool

K & E Drlg. - Contr.

Spudding Date 7-25-51

Drlg. Data Oil well TD 3572

10" @ 200 Anhy 1825 Lans. 3423

TD 3572 5" @ 3570 20/ 3500-05 1 goph

24/ 3474-80 12 goph 1000 A S/ 70 bo

12 hr. PB 3465 24/ 3436-42 5 goph

1000 A S/ 4 1/4 boph S/ 19 1/2 bo 2 hr.

Comp. 104 bopd 15% water

J. E. TYRA

County Phillips State Kansas
 Sec. 28 (Blk. 1 (Sur. 18W Map No.
 Operator National Assoc. Pet.
 Well No. 1 Farm Jackson "B"
 Elev. 2258 Location SW SE SW



330 Ft. From S Line SW

990 Ft. From E Line Quarter

1st. Report AUG 1 1951

Completion

Remarks

K & E Drlg. - Contr.

Spudding Date 7-25-51

Drlg. Data Huffstutter Pool

10" @ 200 Anhy 1825 drlg, 2829

J. E. TYRA