

Sec. 28 Twp. 1 R. 18 W

Well No. # 1 Jackson "D" Farm

National Assoc. Pet. Company

K & E Drlg. Contractor

Stephens Pool


990 Ft. from N. Line

Ft. from S. Line

Ft. from E. Line

330 Ft. from W. Line

SW NW SE

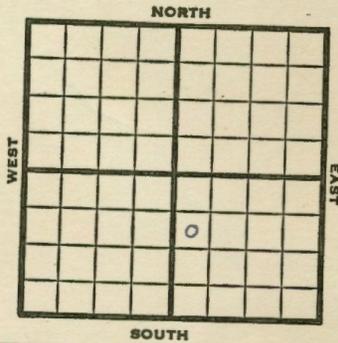

1951 Elev. 2239' REPORT

9/5 R U R

11/21 Spud 9-7-51

Oil well TD 3565' 8" @ 199

Heeb 3385' Lans. 3410-3565'

5" @ 3561 16/3482-86 1000 A

S/1 1/2 BOPH 16/3472-76 1000 A

S/2 1/2 BOPH


Comp. 105 BOPD

COMPLETED

Section 28 Township 1 Range 18W

Well No. #1 Jackson "D"

Company National Assoc. Pet.

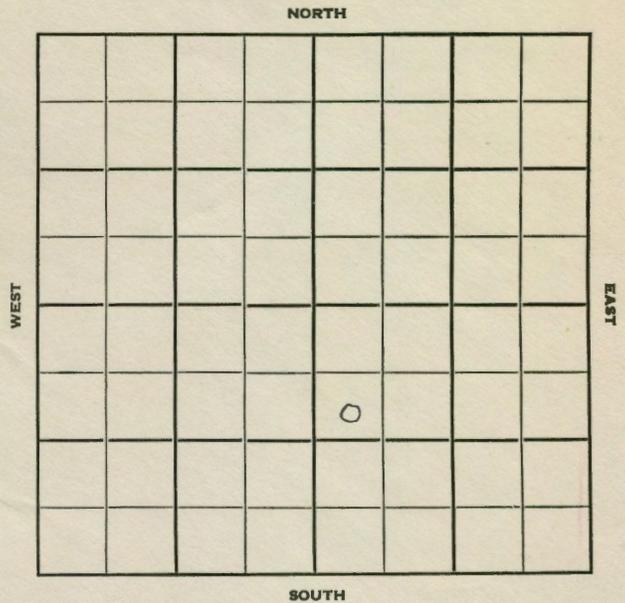

10

