


Phillips **KANSAS**Section 28 Township 1 Range 18WWell No. #3 Jackson "B"Company National Assoc.

NORTH

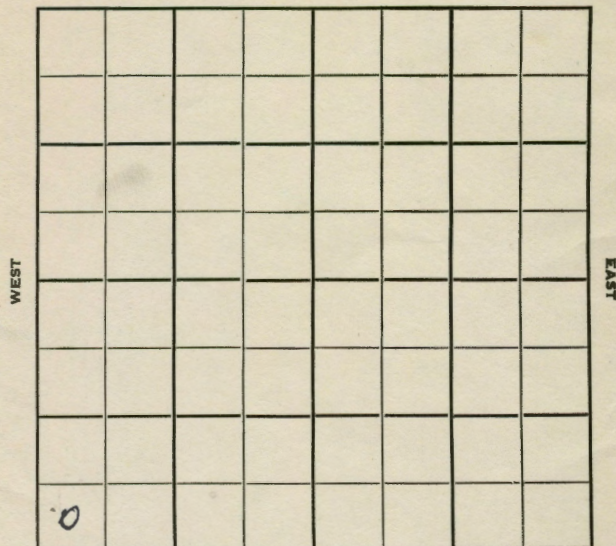

SOUTH

13

nPhillips

KANSASSec. 28 Twp. 1 R. 18WWell No. #3 Jackson (B)

National Assoc. Company

K&E Drlg. Huffstutter Contractor

Ft. from N. Line

330 Ft. from S. Line


Ft. from E. Line

330 Ft. from W. Line

SW SW SW

K

NORTH

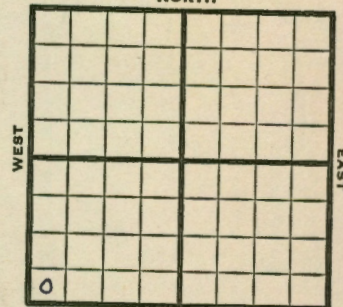

SOUTH

1951 Elev. 2249' REPORT

10/31
12/19

RUR
 Spud 10-29-51
 Oil Well TD 3576'
 8" @ 220'
 Anhy 1820
 Heeb. 3387
 Lans. 3418'
 TD 3376
 5" @ 3564 SP 3495 30/3485-90
 30/ 3470-75 B/ 2 BOPH 1000 A
 S/ 6 BOPH
 Comp. 193 BOPD

COMPLETED

County Phillips State Kansas
 Sec. 28 (Blk. 1 (Sur. 18W Map No.
 Operator National Assoc. Pet.
 Well No. 3 Farm Jackson "B"
 Elev. 2249 Location SW SW SW
 330 Ft. From S Line SW
 330 Ft. From W Line Quarter
 1st. Report DEC 19 1951
 Completion
 Remarks Huffstutter Po
K & E Drlg. - Contr.
 Spudding Date 10-29-51
 Drlg. Data Oil well TD 3576
8" @ 220 Anhy 1820 Heeb. 3387
Lans. 3418 TD 3576 5" @ 3564 SP
3495 30/ 3485-90 30/ 3470-75
B/ 2 boph 1000 A S/ 6 boph
Comp. 193 bopd

J. E. TYRA

County Phillips State Kansas
 Sec. 28 (Blk. 1 (Sur. 18W Map No.
 Operator National Assoc.
 Well No. 3 Farm Jackson (B)
 Elev. Location SW SW SW
 330 Ft. From S Line SW
 330 Ft. From W Line Quarter
 1st. Report OCT 31 1951
 Completion
 Remarks K & E Drlg. - Contr.
 Spudding Date
 Drlg. Data Huffstutter
RUR

J. E. TYRA