



FORM 51 Phillips **KANSAS**
 Section 29 Township 1 Range 18W
 Well No. 1 Davis
 Company J. D. Ferrill Drlg.

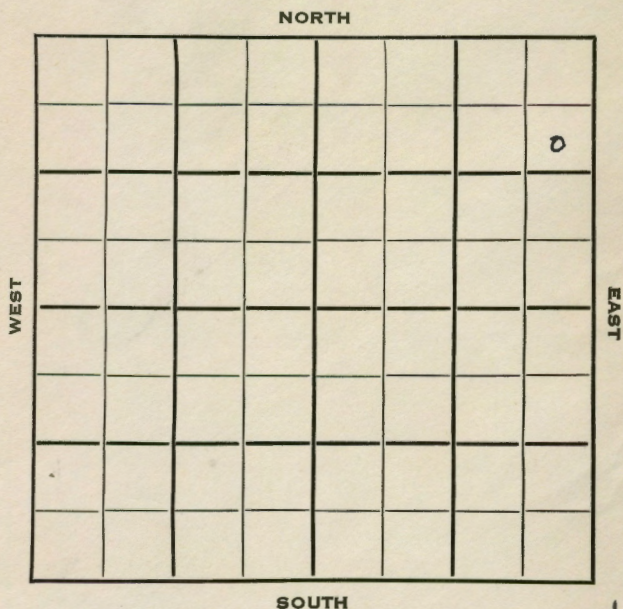

FORM 252-B Phillips **KANSAS**
 Sec. 29 Twp. 1 R. 18 W
 Well No. # 1 Davis Farm
J. D. Ferrill Drlg. Company
Ferrill Drlg. Contractor

990 Ft. from N. Line
 _____ Ft. from S. Line
330 Ft. from E. Line
 _____ Ft. from W. Line

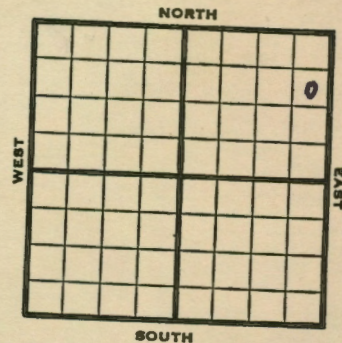

SE NE NE

1952 **Elev. 2169'** REPORT

12/17 RUR
 12/18 RUR
 12/25 RUR
 1/1 RTD 3514 5" @ 3511 WOCT
 1/8 MICT , O T

1/15 **Heeb 3314, Tor 3340, Lans 3360**
 12/3502-06, test dry
 Set plug 3490, 36/3429-39,
 21/3442-45, B/3/4 BOPH 6 hrs.
 2000A
 S/5 BOPH for 12 hrs., testing
 P/3 BOPH 18 hrs.

1/22
 1/28 Spud 12-18-52
 Oil Well
 TD 3514
 8" @ 251
Heeb 3314, Tor 3340, Lans 3360
 TD 3514
 5" @ 3511
 DST 3408-60, opn 1 hr., rec. 60'
 oil, 30' hocm, 30' mud, 460#
 12/3502-06 dry SP 3490
 36/3429-39, 12/3442-45, FU 50'
 oil, 1 1/2 hrs., B/ 3/4 boph 6 hrs.
 500A B/1 boph 12 hrs. 2000A
 S/5 boph 12 hrs. P/3 boph 18 hrs.
 Comp 25 bopd **COMPLETED**

