


KANSAS

Phillips

18-W

Section 29 Township 1 Range 18-W
 Well No. #1 Federal Farms
 Company Powell & Peters

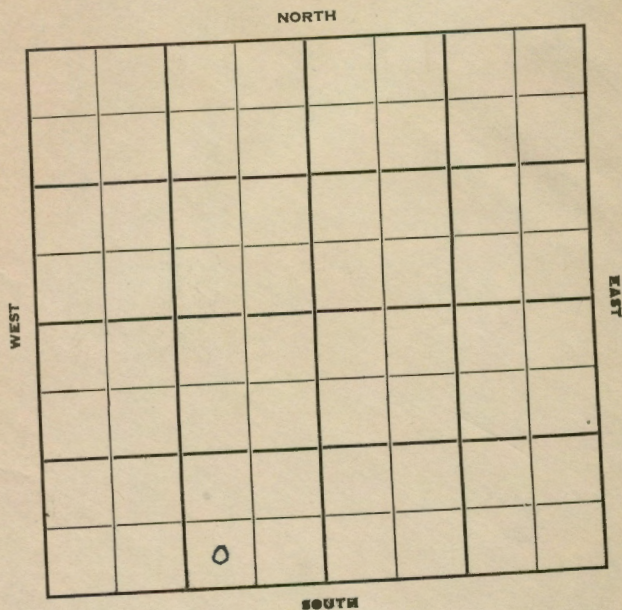

KANSAS


Phillips

18-W

Sec. 29 Twp. 1 R. 18-W
 Well No. #1 Federal Farms Farm
Powell & Peters Company
Huffstutter Contractor

 Ft. from N. Line
330 Ft. from S. Line
990 Ft. from E. Line
 Ft. from W. Line

SW SE SW

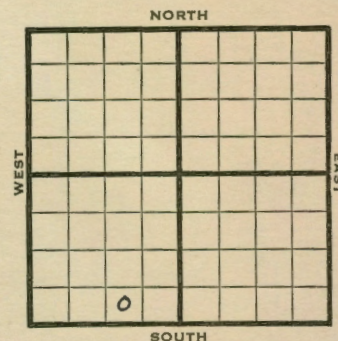


1950 Elev 2263 REPORT

7/19 Cellar & Pits
 9/20 TD 3563
 8" @ 255
 Anhy 1820 Heeb 3404
 Lans 3490
 5" @ 3538
 SP 3548
 16/3520-26, 23/3530-38
 1000 A
 S/1½ boph 4000 A no inc. PB 3512
 19/3496-3502 S/1½ boph 1000 A
 DD 3563 CO to 3545 B/4½ boph SP 3507
 12/3497-3501 1000 A ½ boph 4000 A
 SP 3490 12/3479-83 1000 A S/1 boph
 for 8 hr. Went to water Sq. off
 CO to 3540 31/3530-38 24/3520-26
 1000 A Temporarily abd.

ABANDONED

County Phillips State Kansas
 Sec. 29 (Bk. 1) (Sur. 18W) Map No. 1
 Operator Powell & Peters
 Well No. 1 Farm Federal Farms
 Elev. 2263 Location SW SE SW

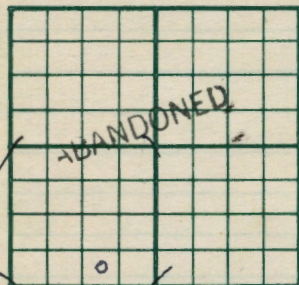

330 Ft. From S Line SW
 990 Ft. From E Line Quarter
 1st. Report SEP 20 1950
 Completion SEP 20 1950
 Remarks
Huffstutter Pool
 Spudding Date 7-22-50

Drig. Data Abd. TD 3563
 8" @ 255 Anhy 1820 Heeb. 3404
 Lens. 3430 5" @ 3558 TD 3558 SP 3548
 16/ 3520-26 23/ 3530-38 1000 A
 S/ 1½ boph 4000 A no inc. PB 3512
 18/ 3496-3502 S/ 1½ boph 1000 A
 DD 3563 CO to 3545 B/ 4½ goph SP 3507
 12/ 3497-3501 1000 A ½ boph 4000 A
 SP 3490 12/ 3479-83 1000 A S/ 1 boph
 for 8 hr. Went to water Sq. off
 CO to 3540 31/ 3530-38 24/ 3520-26
 1000 A Temporarily abd.

J. E. TYRA

Map No. _____ Sec. 29 Twp. 1 R. 18W
 Well No. 1 Federal Farms

Powell & Peters Company
 Contractor

SW SE SW

SECTION PLAT

_____ Ft. from N. Line
330 Ft. from S. Line
990 Ft. from E. Line
 _____ Ft. from W. Line



Phillips County

Location _____
 Rig up _____
 Drilling and Remarks:

Cellar & pits

RECORD

Cased _____ in., _____ ft.
 Sand _____
 Gas _____
 Oil _____
 Total Depth _____

PRODUCTION

1st 24 hrs. Nat. _____
 1st 24 hrs. after shot _____
 Gas _____ Cu. Ft.
 Dry Hole _____
 Abandoned _____

Date

Jul 19 1950

19

J. E. TYRA

Scout