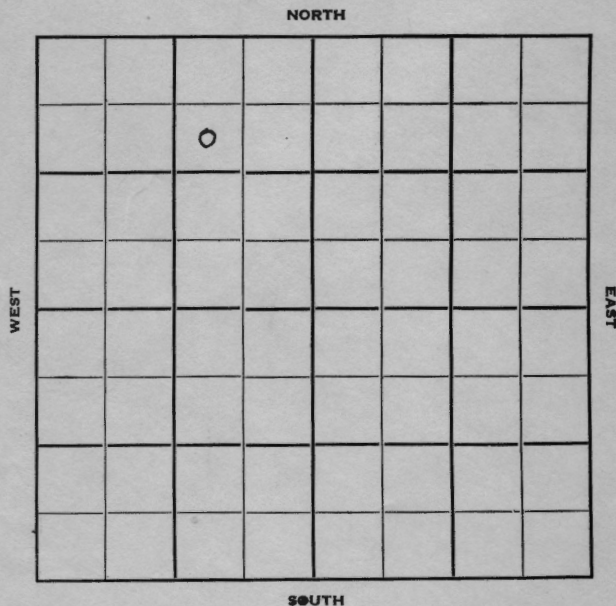


Phillips

KANSAS

Section 33 Township 1 Range 18WWell No. #4 DavisCompany Honaker Drlg.

3

Phillips KANSAS

Sec. 33 Twp. 1 R. 18WWell No. #4 Davis Farm

Honaker Drlg. Company

Honaker Drlg. - Contr. Contractor

Huffstutter


990' Ft. from N. Line

Ft. from S. Line

990' Ft. from E. Line

Ft. from W. Line

SW NE NW

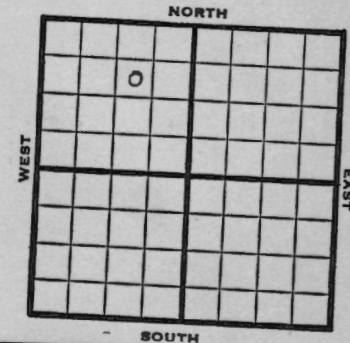

1950 Elev. 2251' REPORT

10/18 Lans. 3428'
TD 3535'
5" @ 3534'
WOC

11/22 Oil Well TD 3535'
Lans. 3415' 5" @ 3534'
TD 3535'
21/3511-16 1000 A 2500 A
S/1 1/2 BOPH PB 3504'
9/3483-86 9/3483-86 1000 A
S/7 BOPH 2500 A S/16 BOPH
Comp. 240 BOPD

COMPLETED

County	Phillips		State	Kansas
Sec.	33 (Blk. Twp.)	1 (Sur. Rge.)	18W	Map No.
Operator	Honaker Drlg.			
Well No.	4	Farm	Davis	
Elev.	2251	Location	SW NE NW	

0

FIRST REPORT

990	Ft. From	H	Line	NW
990	Ft. From	E	Line	Quarter
1st. Report	OCT 18 1950			
Completion				
Remarks	Honaker Drlg. - Contr.			
Spudding Date				

Drig. Data

Lans. 3428 TD 3535 5" @ 3534 WOC

J. E. TYRA

County	Phillips	State	Kansas
Sec.	33 (Blk. Twp.)	1 (Sur. Rge.)	18W Map No.
Operator	Honaker Drlg.		
Well No.	4	Farm	Davis
Elev.	2251	Location	SW NE NW

990 Ft. From	N Line	NW
990 Ft. From	E Line	Quarter
1st. Report		
Completion NOV 22 1950		
Remarks	Huffstutter Pool	
Honaker Drlg. - Contr.		
Spudding Date		

Drilg. Data	Oil well	TD 3535
Lens. 3415	5" @ 3534	TD 3535
21/ 3511-16	1000 A	2500 A S/ 1 1/2 bopd
PB 3504	9/ 3483-86	9/ 3483-86 1000 A
S/ 7 bopd	2500 A	S/ 16 bopd
Comp. 240 bopd		

J. E. TYRA