

KANSAS

Phillips

Phillips **KANSAS**

Sec. 32 Twp. 1 R. 18W



Section 32 Township 1 Range 18-W

Well No. #1 Huffstutter "E"

Company Stabledoor Huffstutter Pool
NORTH

Well No. #1 Huffstutter "E" Farm
Stabledoor Company
Huffstutter Pool (B&R Drlg., Contr.)
NORTH

_____ Ft. from N. Line
330' Ft. from S. Line
990' Ft. from E. Line
_____ Ft. from W. Line
SW SE SW

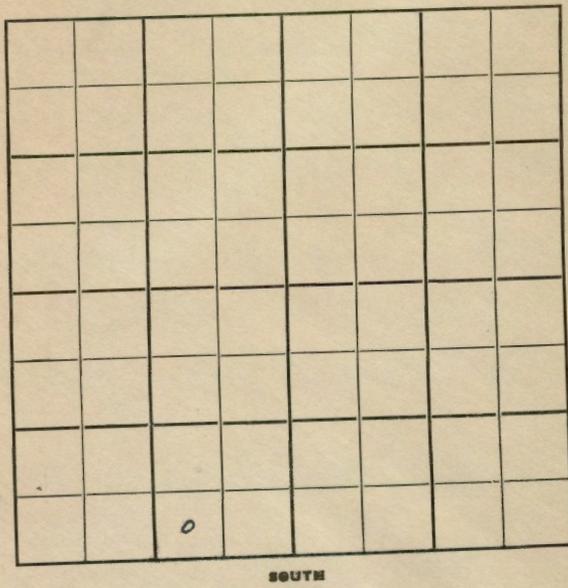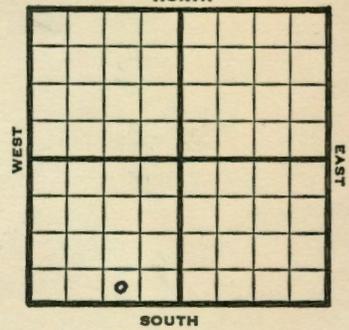

14

1949		Elev 2208'	REPORT
11/30	Location		
12/7	"		
12/14	8" @ 160'		
	Drlg. 2320'		
12/21	Lansing 3355'		
	TD 3467'		
	5" @ 3467'		
12/28	36 shots 3448-56	5000 acid	
	Swb 2 bbls oil PH		
1950			
1/18	TD 3467'		
	8" @ 160'		
	5" @ 3467'		
	Lan 3355'		
	Perfs 36/3448-56		
	Used 5000 gals acid		
	PP 96 bbls OPD		
	no wtr.		
	Comp		
	COMPLETED		

Kansas

Map No. _____ Sec. 32 Twp. 1 R. 18W

Well No. 1 Huffstutter "E"

Stabledoor _____ Company _____

Contractor _____
SW SE SW *FIN. 2208*

SECTION PLAT

_____ Ft. from N. Line
330 _____ Ft. from S. Line
990 _____ Ft. from E. Line
_____ Ft. from W. Line

COMPLETE			

Phillips County

Location _____

Rig up _____

Drilling and Remarks:

8" @ 160'
5" @ 3467
Jan 3355
Perf 36/3448-56
used 5000 gals acid.
PP 90 BOPD
No Water

Date

JAN 18 1950

19

J. E. TYRA

Scout

RECORD

Cased _____ in., _____ ft.

Sand _____

Gas _____

Oil _____

Total Depth *3467*

PRODUCTION

1st 24 hrs. Nat. _____

1st 24 hrs. after shot _____

Gas _____ Cu. Ft.

Dry Hole _____

Abandoned _____

Kansas

Map No. _____ Sec. 32 Twp. 1 R. 18W

Well No. 1 Huffstutter "E"

Stabledoor _____ Company _____

Contractor _____
B & R Drlg.

SW SE SW

FIRST REPORT

SECTION PLAT

_____ Ft. from N. Line
330 _____ Ft. from S. Line
990 _____ Ft. from E. Line
_____ Ft. from W. Line

Phillips County

Location _____

Rig up _____

Drilling and Remarks:

RECORD

Cased _____ in., _____ ft.

Sand _____

Gas _____

Oil _____

Total Depth _____

PRODUCTION

1st 24 hrs. Nat. _____

1st 24 hrs. after shot _____

Gas _____ Cu. Ft.

Dry Hole _____

Abandoned _____

Date

NOV 30 1949

19

S. J. LEWIS

Scout