


Section 32 Township 1 Range 18W
Well No. #7 Huffstutter "E"
Company B & R Drlg.

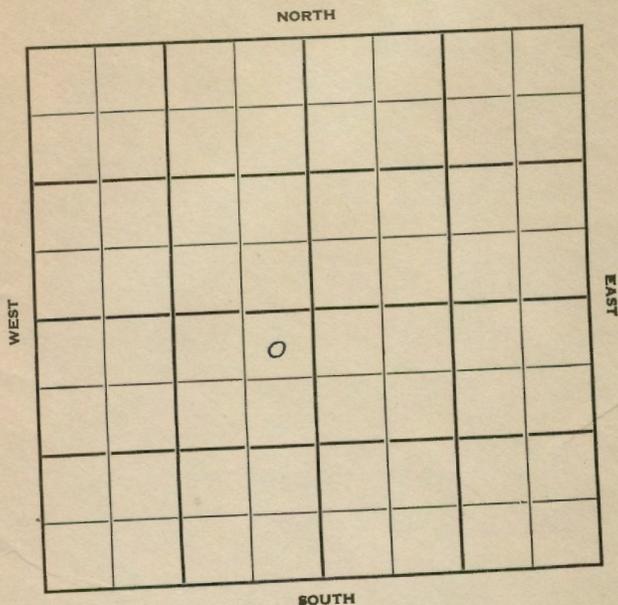

11

Sec. 32 Twp. 1 R. 18W

Well No. #7 Huffstutter "B" "E" Far

B & R Drlg. Company

B & R Drlg. Contract

Huffstutter Pool


330' Ft. from N. Line

Ft. from S. Line

330' Ft. from E. Line

Ft. from W. Line

NE NE SW

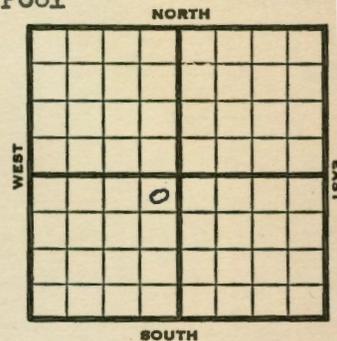

1951 **Elev. 2234'** REPORT

8/22 Location
 10/31 Spud 8-25-51
 Oil Well TD 3517
 8" @ 189
Heeb 3376 Lans. 3403
 TD 3517
 5" @ 3517 12/3511-15
 11/ 3500-04 2000 A S/ 1 BOPH
 11/ 3474-78 2/3 BOPH 2000 A
 S/ 2 BOPH SP 3467 24/ 3456-64
 S/ 2 BOPH 3000 A No inc.
 CO to 3517
 Comp. 80 BOPD

COMPLETED

