


Section 31 Township 1 Range 18-W

Well No. #2 Huffstutter "D"

Company B & R Drlg.

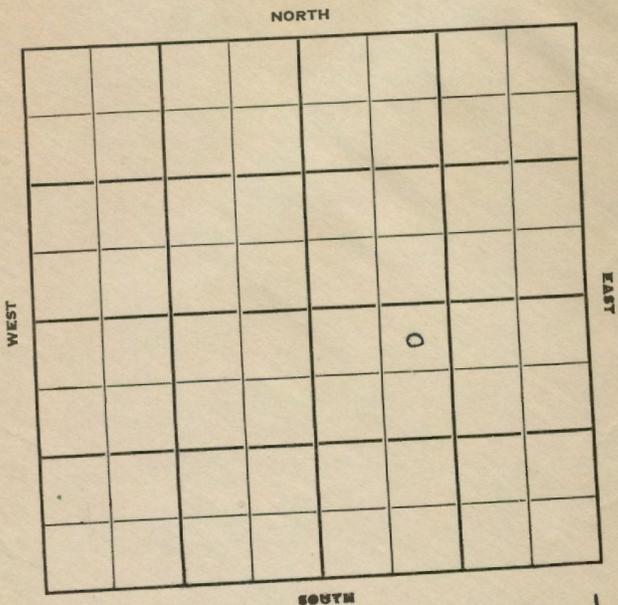

10

Sec. 31 Twp. 1 R. 18W

Well No. #2 Huffstutter "D" Farm

B & R Drlg. Company

B & R Drlg. Contractor

Huffstutter Pool


330' Ft. from N. Line

\_\_\_\_\_ Ft. from S. Line

\_\_\_\_\_ Ft. from E. Line

990' Ft. from W. Line

NE NW SE

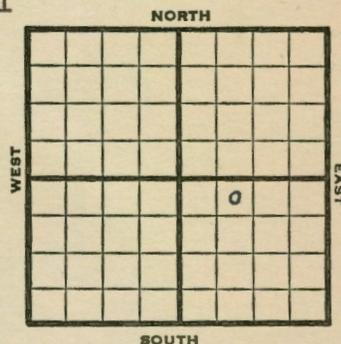

1950 **Elev. 2259'** REPORT

9/20 Location  
 11/15 Spud 9-26-50  
 Oil Well TD 3533'  
 8" @ 182'  
**Anhy 1825'**  
**Heeb. 3390'**  
**Lans. 3418'**  
 TD 3533'  
 5" @ 3533'  
 12/3524-28 B 1 BOPH 12/3516-20  
 B/2 BOPH 4000 A S/5 BOPH  
 S/10 BOPH Comp. 281 BOPD

**COMPLETED**

