


Phillips **KANSAS**

Section 32 Township 1 Range 18W
 Well No. #2 Davis
 Company Powell & Peters

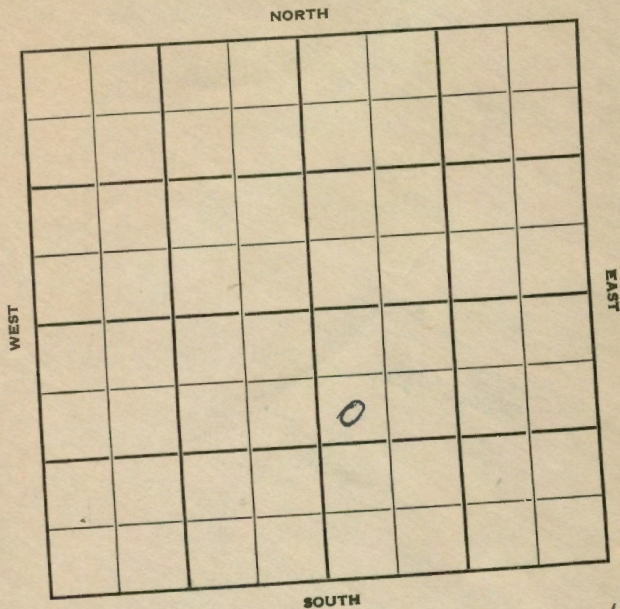

10

Phillips **KANSAS**

Sec. 32 Twp. 1 R. 18W ✓

Well No. #2 Davis Farm
Powell & Peters Company
Huffstutter Contractor


990' Ft. from N. Line

Ft. from S. Line

Ft. from E. Line

330' Ft. from W. Line

SW NW SE

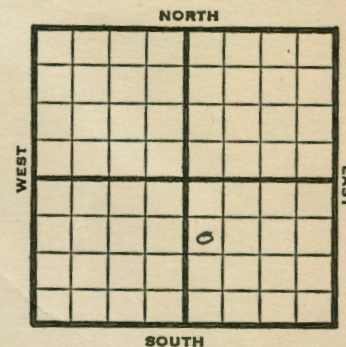

1950

Elev. 2221' REPORT

1/25

Location

3/22

8 5/8" @ 190'

Heebner 3341'**Lans 3367'**

SD 3383-88 3420-23

TD 3470'

1000 acid

Swab 33 Oil in 4 hrs.

3500 acid

Swab 22 Oil pr hr

Comp 139 BOPD

Comp

COMPLETED

Kansas

Huffstutter

Map No. _____ Sec. 32 Twp. 1 R. 18WWell No. 2 DavisPowell & Peters Company

Contractor

SW NW SE


E/ 2221

SECTION PLAT

990 Ft. from N. Line

Ft. from S. Line

Ft. from E. Line

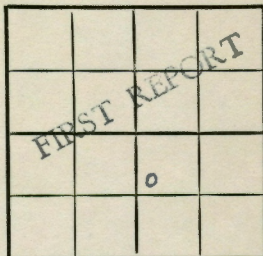330 Ft. from W. Line

Phillips County

Location X

RECORD

Cased _____ in., _____ ft.

Sand _____

Gas _____

Oil _____

Total Depth _____

PRODUCTION

1st 24 hrs. Nat. _____

1st 24 hrs. after shot _____

Gas _____ Cu. Ft.

Dry Hole _____

Abandoned _____

Date

JAN 25 1950 19 J. E. TYRA Scout

Kansas

Huffstutter Pool

Map No. _____ Sec. 32 Twp. 1 R. 18WWell No. 2 DavisPowell & Peters Company

Contractor

SW NW SE


E/ 2221

SECTION PLAT

990 Ft. from N. Line

Ft. from S. Line

Ft. from E. Line

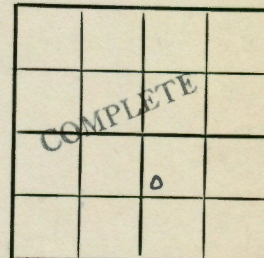330 Ft. from W. Line

Phillips County

Location _____

RECORD

Cased _____ in., _____ ft.

Sand _____

Gas _____

Oil _____

Total Depth _____

PRODUCTION

1st 24 hrs. Nat. _____

1st 24 hrs. after shot _____

Gas _____ Cu. Ft.

Dry Hole _____

Abandoned _____

Rig up _____

Drilling and Remarks:

8 5/8 @ 190Hebner 3341Pause. 3367SD 3383-88 3420-23TID. 34701000 acidSwab 33 oil in 4 hrs.3500 acidSwab 22 oil per hr.Comp. 139 BOPD

Date

MAR 22 1950 19 J. E. TYRA Scout