



Section 32 Township 1 Range 18W
Well No. #3 Davis
Company Peters Drlg.

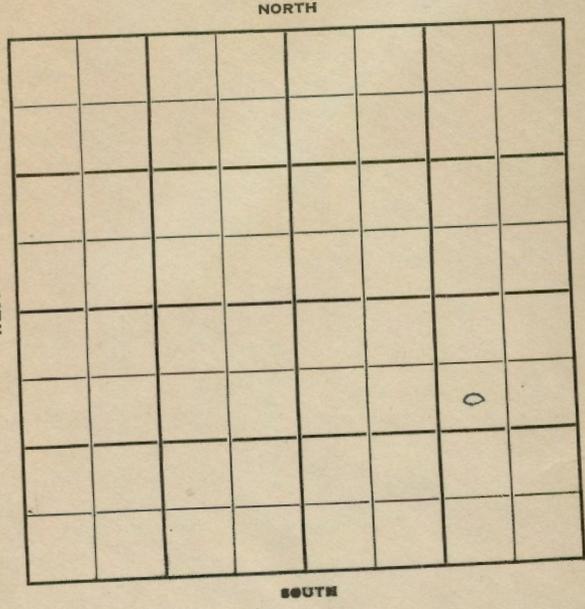

9

Sec. 32 Twp. 1 R. 18-W
Well No. #3 Davis Farm
Peters Drlg Company
Huffstutter Pool

990 Ft. from N. Line
Ft. from S. Line
990 Ft. from E. Line
Ft. from W. Line

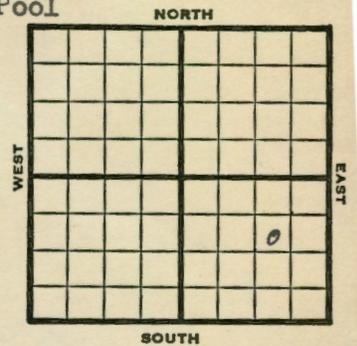

SW NE SE

1950 **Elev 2280'** REPORT

2/22 Location
4/5 TD 3547'
8 5/8" @ 210'
5" @ 3547'
Lans 3427'
Perf 12/3510-14
Perf 12/3501-04'
P/ 121 BOPD
Comp

COMPLETED

Kansas

Map No. _____ Sec. 32 Twp. 1 R. 18W

Well No. 3 Davis

Peters Drlg. _____ Company

Contractor

SW NE SE

EI. 2280
SECTION PLAT

990 Ft. from N. Line

_____ Ft. from S. Line

990 Ft. from E. Line

_____ Ft. from W. Line

			0

Phillips County

Location _____

Rig up _____

Drilling and Remarks:

8 5/8 @ 210
 5" @ 3547
 Lens 3427
 prof 12/3510-14
 12/3501-04
 P 121 BOPD

RECORD

Cased _____ in., _____ ft.

Sand _____

Gas _____

Oil _____

Total Depth 3547

PRODUCTION

1st 24 hrs. Nat. _____

1st 24 hrs. after shot _____

Gas _____ Cu. Ft.

Dry Hole _____

Abandoned _____

Date

APR 5 1950 19

J. E. TYRA

Scout

Kansas

Map No. _____ Sec. 32 Twp. 1 R. 18W

Well No. 3 Davis

Peters Drlg. _____ Company

Contractor

SW NE SE

SECTION PLAT

990 Ft. from N. Line

_____ Ft. from S. Line

990 Ft. from E. Line

_____ Ft. from W. Line

			0

FIRST REPORT

Phillips County

Location _____ X

Rig up _____

Drilling and Remarks:

RECORD

Cased _____ in., _____ ft.

Sand _____

Gas _____

Oil _____

Total Depth _____

PRODUCTION

1st 24 hrs. Nat. _____

1st 24 hrs. after shot _____

Gas _____ Cu. Ft.

Dry Hole _____

Abandoned _____

Date

FEB 22 1950 19

J. E. TYRA

Scout