


Phillips **KANSAS**

Section 32 Township 1 Range 18W

Well No. #5 Davis

Company Powell & Peters

NORTH

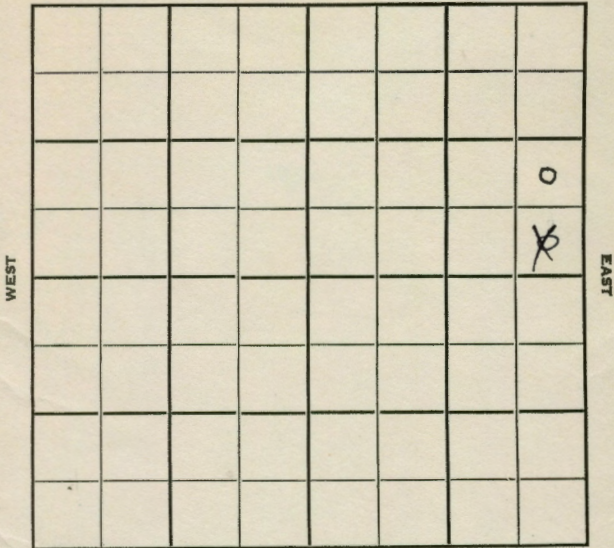

SOUTH

8

KANSAS

Phillips

Sec. 32 Twp. 1 R. 18W

Well No. #5 Davis Farm _____

Powell & Peters Company _____

Honaker Drlg. - Contr. Contractor _____

_____ Ft. from N. Line


330' 990 Ft. from S. Line

330' Ft. from E. Line

_____ Ft. from W. Line

NE
SE SE NE

NORTH

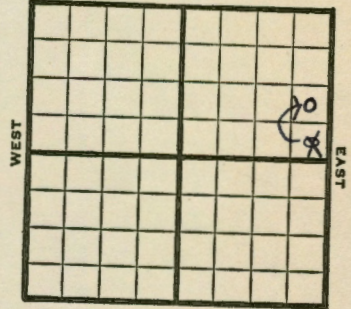

SOUTH

1950 **Elev. 2245'** REPORT

11/22 Spud 11-14-50
Drlg. 3128'

1951
1/10 Spud 11-14-50
Oil Well TD 3527
8" @ 248' **Anhy 1810-50**
Laps. 3417-3527 TD
5" @ 3526 24/3504-09
S/1 boph 1000 A S/9 boph
4000 A S/72 bo in 8 hr.
Comp. 240 bopd

COMPLETED

Kansas

Map No. _____ Sec. 32 Twp. 1 R. 18W

Well No. 5 Davis

Powell & Peters Company

CORRECTION Contractor

NE SE NE

SECTION PLAT

_____ Ft. from N. Line

990 Ft. from S. Line

330 Ft. from E. Line

_____ Ft. from W. Line

			o

Phillips County

Location _____

Rig up _____

Drilling and Remarks:

Reported

SE SE NE

RECORD

Cased _____ in., _____ ft.

Sand _____

Gas _____

Oil _____

Total Depth _____

PRODUCTION

1st 24 hrs. Nat. _____

1st 24 hrs. after shot _____

Gas _____ Cu. Ft.

Dry Hole _____

Abandoned _____

Date

DEC 6 1960 19

J. E. TYRA Scout

