


Phillips

KANSAS

18W  
10W

Section 32 Township 1 Range 10W  
Well No. #2 Huffstutter "E"  
Company B & R Drlg.

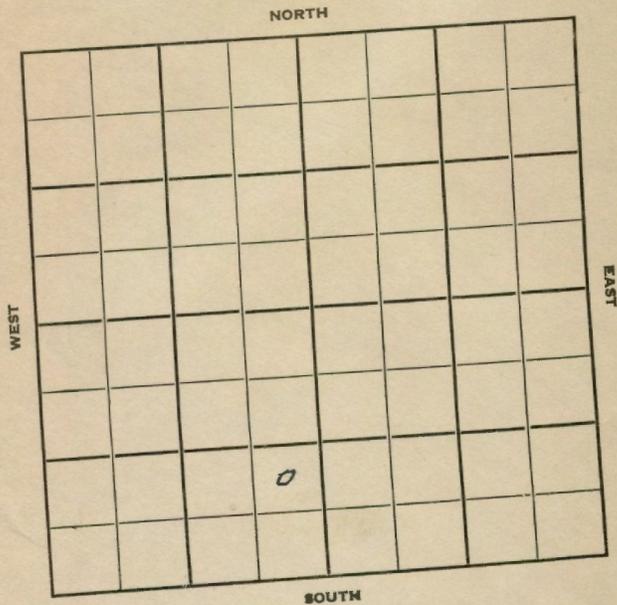

14


Phillips KANSAS

Sec. 32 Twp. 1 R. 18W

Well No. #2 Huffstutter "E" Farm \_\_\_\_\_  
B & R Drlg. Company \_\_\_\_\_

Huffstutter Pool

\_\_\_\_\_ Ft. from N. Line  
990' Ft. from S. Line  
330' Ft. from E. Line  
\_\_\_\_\_ Ft. from W. Line  
NE SE SW

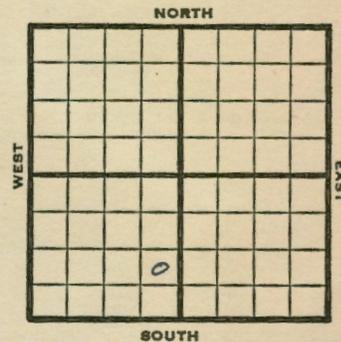

1950 **Elev 2212** REPORT

4/26 Spud 4-25-50  
Drlg.  
6/21 TD 3460  
8" @ 200  
**Heeb 3330**  
5" @ 3450  
set plug 3424  
24/5413-21  
S1 boph  
1000 acid  
S/2 boph  
Comp 78 bopd  
Completed

**Lans 3356**

**COMPLETED**

Kansas

Map No. \_\_\_\_\_ Sec. 32 Twp. 1 R. 18W

Well No. 2 Huffstutter "E"

B & R Drlg. \_\_\_\_\_ Company

Contractor

NE SE SW

Fl. 2212  
SECTION PLAT

\_\_\_\_\_ Ft. from N. Line

990 \_\_\_\_\_ Ft. from S. Line

330 \_\_\_\_\_ Ft. from E. Line

\_\_\_\_\_ Ft. from W. Line

	0		

Phillips County

Location \_\_\_\_\_

Rig up \_\_\_\_\_

Drilling and Remarks:

8" @ 200  
 Heeb. 3330  
 Lans. 3356  
 5" @ 3450  
 TD 3460  
 set plug 3424  
 24/ 3413-21

RECORD

Cased \_\_\_\_\_ in., \_\_\_\_\_ ft.  
 Sand \_\_\_\_\_  
 Gas \_\_\_\_\_  
 Oil \_\_\_\_\_  
 Total Depth 3460

PRODUCTION

1st 24 hrs. Nat. \_\_\_\_\_  
 1st 24 hrs. after shot \_\_\_\_\_  
 Gas \_\_\_\_\_ Cu. Ft.  
 Dry Hole \_\_\_\_\_  
 Abandoned \_\_\_\_\_

Date

JUN 21 1950 19

J. E. TYRA Scout

Kansas

Map No. \_\_\_\_\_ Sec. 32 Twp. 1 R. 18W

Well No. 2 Huffstutter "E"

B & R Drlg. \_\_\_\_\_ Company

Contractor

NE SE SW

SECTION PLAT

\_\_\_\_\_ Ft. from N. Line

990 \_\_\_\_\_ Ft. from S. Line

330 \_\_\_\_\_ Ft. from E. Line

\_\_\_\_\_ Ft. from W. Line

	0		

Phillips County

Location \_\_\_\_\_

Rig up \_\_\_\_\_

Drilling and Remarks:

Spud 4-25-50  
 drlg.

RECORD

Cased \_\_\_\_\_ in., \_\_\_\_\_ ft.  
 Sand \_\_\_\_\_  
 Gas \_\_\_\_\_  
 Oil \_\_\_\_\_  
 Total Depth \_\_\_\_\_

PRODUCTION

1st 24 hrs. Nat. \_\_\_\_\_  
 1st 24 hrs. after shot \_\_\_\_\_  
 Gas \_\_\_\_\_ Cu. Ft.  
 Dry Hole \_\_\_\_\_  
 Abandoned \_\_\_\_\_

Date

JUN 26 1950 19

J. E. TYRA Scout