


Section 32 Township 1 Range 18 W

Well No. # 4 Huffstutter (E)

Company B & R Drilling

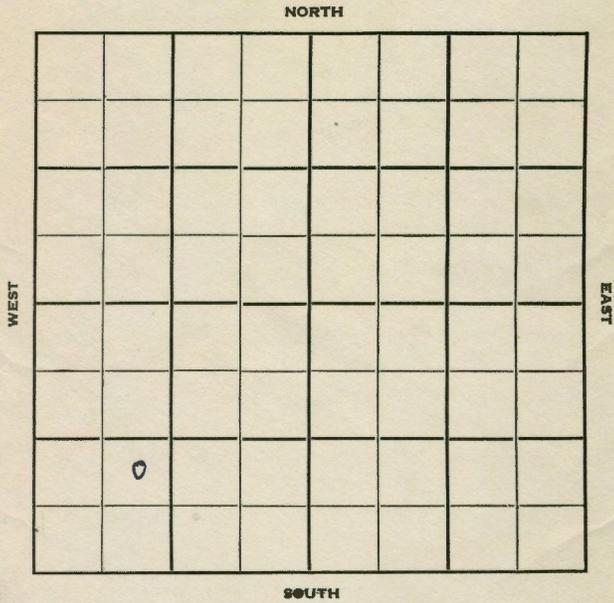

13

Phillips **KANSAS**
Sec. 32 Twp. 1 R. 18 W

Well No. #4 Huffstutter (E) Farm

B & R Drilling Company

Contractor

Huffstutter Pool


Ft. from N. Line

990' Ft. from S. Line

Ft. from E. Line

990' Ft. from W. Line

NE SW SW

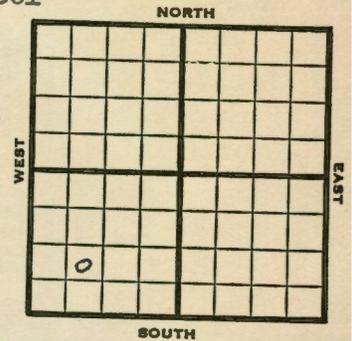

1951 **Elev. 2197'** REPORT

7/3 Spud 6-30-51
8" @ 156'
Drlg. 400'

9/19 Spud 6-30-51
Oil well TD 3471' 8" @ 156
Heeb 3328' **Lans. 3355'** TD 3471'
5" @ 3471 24/3462-70 24/3450-5
1 GOPH 12/3432-36 12/3425-29
2000 A no inc. SP 3420'
24/3407-15 2000 A 36/3406-14
12/3424-28 16/3424-28 24/3406-
14. 1000 A B/1½ BOPH 3000 A
S/2 BOPH
Comp. 80 BOPD

COMPLETED

