


KANSAS

Phillips

Section 33 Township 1 Range 18-W
Well No. #2 Jackson
Company A. C. Maxwell

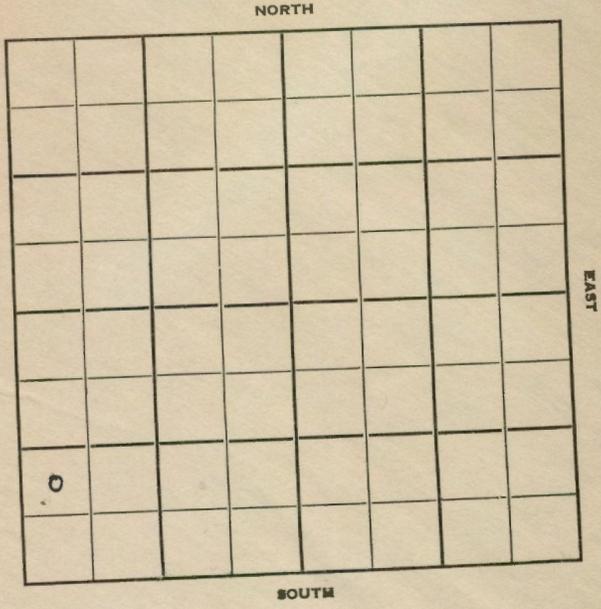


13

Phillips

KANSAS 18W ✓

Sec. 33 Twp. 1 R. 18W
Well No. #2 Jackson Farm
A.C. Maxwell Company
Maxwell - Contr. Contractor
Huffstutter Pool

990' Ft. from N. Line
330' Ft. from S. Line
Ft. from E. Line
330' Ft. from W. Line
NW SW SW

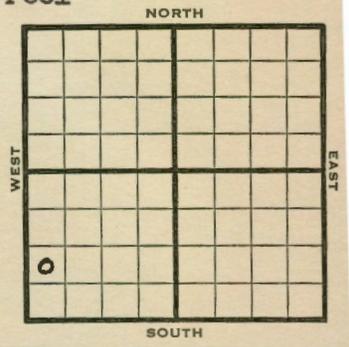

1950	Elev. 2286' REPORT
8/16	Cellar & Pits
11/1	Spud 8-14-50
	Oil Well TD 3550'
	8-5/8" @ 268'
	Lans. 3443' TD 3550'
	5" @ 3550' CO to 3544
	30/3538-43 1000 A S/3 1/2 BOPH
	4000 A S/6 BOPH
	Comp. 170 BOPD
	COMPLETED

