



Section 33 Township 1 Range 18W
Well No. #3 Jackson
Company A. C. Maxwell et al

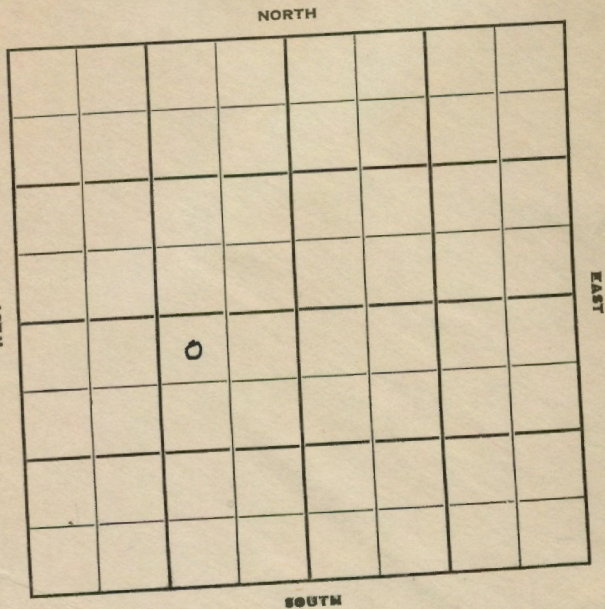

Sec. 33 Twp. 1 R. 18W
Well No. #3 Jackson Farm
A. C. Maxwell et al Company
Maxwell - Contr. Contractor
Huffstutter Pool

330' Ft. from N. Line
Ft. from S. Line
990' Ft. from E. Line
Ft. from W. Line

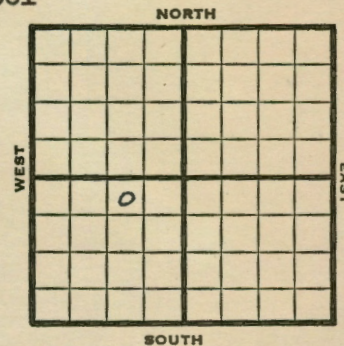

NW NE SW

1950 **Elev. 2280'** REPORT

9/13 Spud 9-5-50
8" @ 268'
Drlg. 3250'
11/1 Spud 9-5-50
Oil Well TD 3580
8" @ 268' **KC 3444'**
TD 3580
5½" @ 3580'
CO to 3575 36/3541-46 500 A
S/6 BOPH Comp. 180 BOPD

COMPLETED

County Phillips State Kansas
Sec. 33 (Blk. 1) (Sur. 18W) Map No.
Operator A. C. Maxwell etal.
Well No. 3 Farm Jackson
Elev. 2280 Corr. Location NW NE SW

| | | | | | |
|--|--|--|--|--|--|
| | | | | | |
| | | | | | |
330 Ft. From N Line SW
990 Ft. From E Line Quarter
1st. Report
Completion NOV 1 1950
Remarks Huffstutter Pool
Maxwell - Contr.
Spudding Date 9-5-50

Drlg. Data Oil well TD 3580
8" @ 268 KC 3444 TD 3580 5 1/2" @ 3580
CO to 3575 36/ 3541-46 500A
S/ 6 boph Comp. 180 bopd

J. E. TYRA

County Phillips State Kansas
Sec. 33 (Blk. 1) (Sur. 18W) Map No.
Operator A. C. Maxwell etal.
Well No. 3 Farm Jackson
Elev. Location NW NE SW

| | | | | | |
|--|--|--|--|--|--|
| | | | | | |
| | | | | | |
330 Ft. From N Line SW
990 Ft. From E Line Quarter
1st. Report SEP 13 1950
Completion
Remarks
Spudding Date 9-5-50

Drlg. Data Huffstutter Pool
8" @ 268 drlg. 3250

J. E. TYRA