


KANSAS Phillips

Section 36 Township 1 Range 19-WWell No. #1 Brockett Est.Company Honaker Drlg.

NORTH

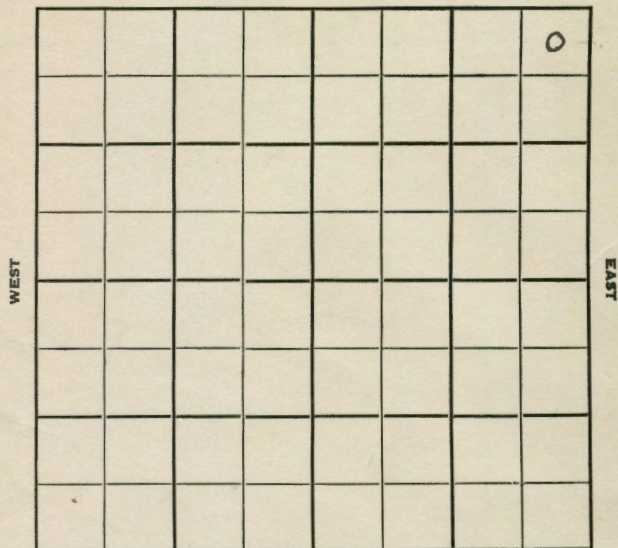

SOUTH

KANSAS

Phillips


Sec. 36 Twp. 1 R. 19W ✓Well No. #1 Brockett Est. FarmHonaker Drlg. CompanyHonaker Drlg. - Contr. Contractor

Huffstutter Pool

330' Ft. from N. Line Ft. from S. Line330' Ft. from E. Line Ft. from W. Line

NE NE NE

NORTH

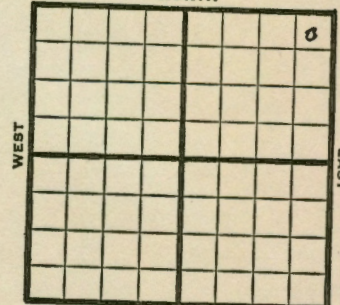

SOUTH

1950

Elev. 2214' REPORT

11/1

Spud 10-25-50

8" @ 222'

Anhy 1790'

Drlg. 2647'

12/27

Spud 10-25-50

Oil Well TD 3528

8" @ 222'

Anhy 1824 Heeb. 3360

Lans. 3380 TD 3528

5" @ 3527

24/3498-3502 5000 A P/40 BOPD


Comp. 103 BOPD

COMPLETED

Drlg. Data	Huffstatter Pool
8" @ 222 Anhy 1790	drlg. 2647

J. E. TYDA

County	Phillips			State	Kansas
Sec.	36	(Blk. Twp.)	1	(Sur. Rge.)	19W Map No.
Operator	Honaker Drlg.				
Well No.	1	Farm	Brockett Est.		
Elev.	2214	Location	NE NE NE		

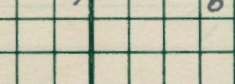	330 Ft. From N Line	NE
	330 Ft. From E Line	Quarter
	1st. Report	
	Completion DEC 27 1950	
Remarks Huffstutter Pool		
Honaker Drlg. - Contr.		
Spudding Date		10-25-50

Drig. Data	Oil well	TD 3528
8" @ 222	Anhy 1824	Heeb. 3360
Lens. 3380	TD 3528	5" @ 3527
24/ 3498-3502	5000 A	P/ 40 bopd
Comp. 103 bopd		

J. E. TYRA