


Section 25 Township 1 Range 19W

Well No. #1 McKenzie

Company Honaker Drlg.

NORTH

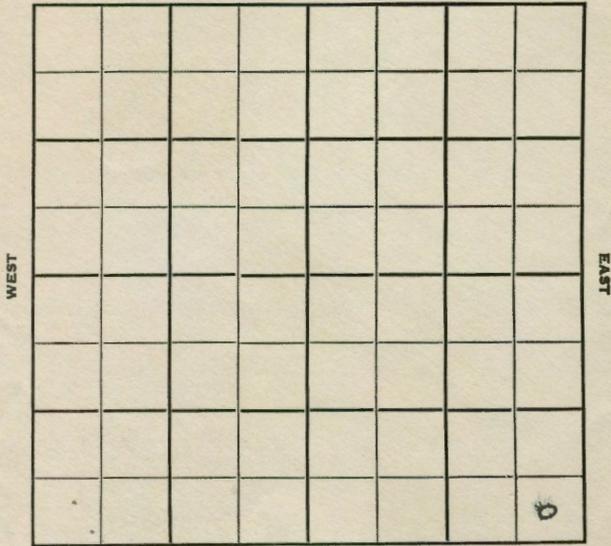

SOUTH

16

Sec. 25 Twp. 1 R. 19W ✓

Well No. #1 McKenzie Farm

Honaker Drlg. Company

Huffstutter Pool Contractor

_____ Ft. from N. Line


330' Ft. from S. Line

330' Ft. from E. Line

_____ Ft. from W. Line

SE SE SE

NORTH

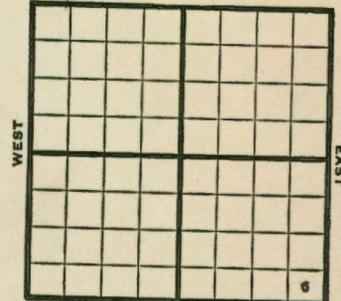

SOUTH

1950

Elev. 2230' REPORT

12/6

Location

3/21

Oil Well TD 3545

8" @ 175'

Anhy 1800' Heeb. 3381

Lans. 3410'

TD 3545' 5" @ 3544

CO to 3540 20/3529 $\frac{1}{2}$ -31 $\frac{1}{2}$ 500 A

S $\frac{1}{2}$ boph 2000 A S/1 $\frac{1}{2}$ boph

4000 A Comp. 17 bopd

COMPLETED

