


Section 13 Township 1 Range 20W.
 Well No. #1 Woodruff
 Company K & E Drilling

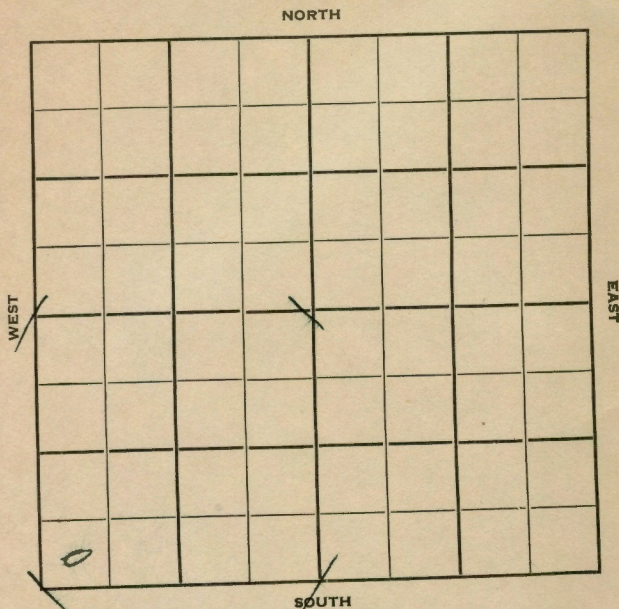


13

Sec. 13 Twp. 1 R. 20 W
 Well No. # 1 Woodruff Farm
K & E Drlg. Company
K & E Drlg. Contractor

Wildcat

Ft. from N. Line
330 Ft. from S. Line
 Ft. from E. Line
330 Ft. from W. Line

SW SW SW
 MCPG has SW of 14 &
 SE of 11

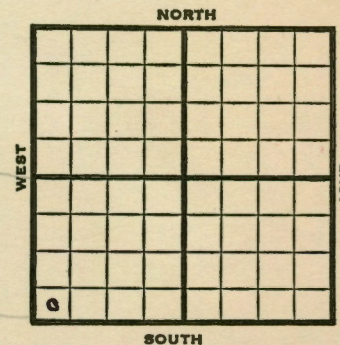

1952 Elev. 2069' REPORT

1/2 Location
 1/4 " (Ltr)
 1/11 Spudded 12-19-51
 Set 8" @ 202'
 Heeb 3310' Lans. 3336'
 DST 3338-72', open 45 min, rec 47'
 VSOCM.
 TD 3624' D & A (Ltr)
 1/9 Spud 12-19-51
 D & A - TD 3624'
 8" @ 202' Heeb 3310' Lans. 3336'
 DST 3338-72 open 45 min, rec 47' VSO &
 GCM. TD 3624' D & A

ABANDONED

[illegible]

J. E. TYRA

County Phillips State Kansas

Sec. 13 (Blk. 1) (Sur. 20W) Map No. 1

Operator K & E Drlg.

Well No. 1 Farm Woodruff

Elev. _____ Location SW SW SW

330 Ft. From S Line SW

330 Ft. From W Line _____ Quarter _____

1st. Report JAN 2 1952

Completion _____

Remarks MCPC has SW of 14 & SE of 11
K & E Drlg. - Contr.

Spudding Date _____

Drlg. Data _____

Location Wildcat

J. E. TYRA