


Section 32 Township 1 Range 23 WWell No. #1 Browne "B"Company Jones, Shelburne & Farmer

NORTH

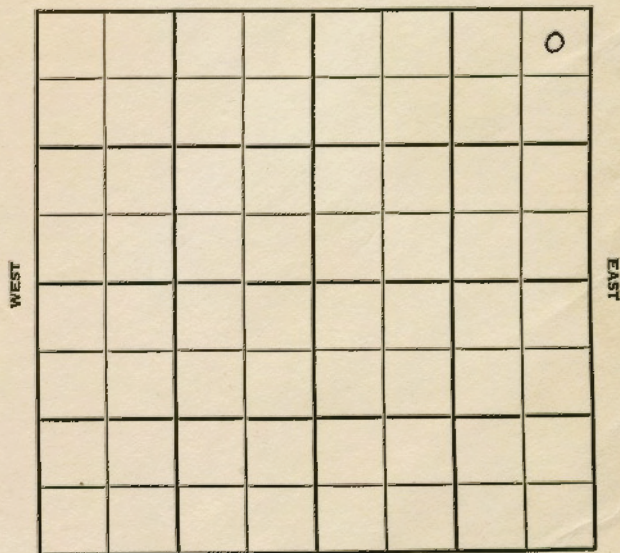

SOUTH

SEC.	32	TWP.	1	R.	23W
------	----	------	---	----	-----

WELL NO.

#1 Browne "B"

FARM

COMPANY

Jones, Shelburne & Farmer

CONTRACTOR

Co. Tools

Wildcat

_____ Ft. from N. Line


_____ Ft. from S. Line

_____ Ft. from E. Line

_____ Ft. from W. Line

NE NE NE

NORTH

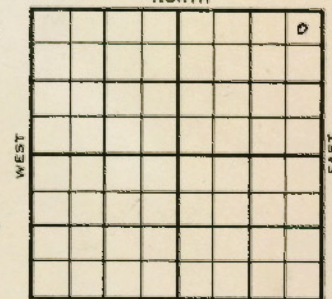

SOUTH

	ELEVATION	REPORT
--	-----------	--------

1955

2458'

10/12

Drlg 2508

Anh 1993

10/26

Comm 10-17-55

Anh

1993

H

3426

Tr

3460

L

3471

BKC

3661

Wash

3708

Gr

3739

TD

3738

8 5/8" @ 200/150

DST 3501-17 open 15 min rec 5' wmi

1110/20"

D & A

ABANDONED

County Norton Elev. 23W
 Sec. 32 Twp. 1 Rge. 23W
 Company Jones, Shelburne & Farmer
 FarmName Browne No. 1

TOPS	DEPTH	LOG	DATUM	Loc. in Sec.
Anh.	1993			NE NE NE
Tr.				
H.				
Dg.				
BL.				
L.				
K.C.				Geol.
B.K.C.				Contr.
Ce.				Co. tools
C.				
M.				Pool
K.				Wildcat
Mz.				
Me.				
V.				
S.				
A.				
R.				
Pe.				
G.				
TD.				

OCT 12 1955
 FIRST REPORT

Date Comm. drlg. 2508

County Norton Elev. 2458
 Sec. 32 Twp. 1 Rge. 23W
 Company Jones, Shelburne & Farmer
 FarmName Browne "B" No. 1

TOPS	DEPTH	LOG	DATUM	Loc. in Sec.
Anh.	1993			NE NE NE
Tr.				
H.	3426		9168	
Tr.	3460		1002	
Dg.				
BL.				
L.	3471		1013	
K.C.				Geol.
B.K.C.	3661		1203	Contr.
Ce.				Co. tools
C.				
M.				Pool
K.				Wildcat
Mz.				
Me.				
V.				
S.				
A.				
R.				
Pe.				
G.	3708		1350	
	3730		1272	
TD.	3738			

ABANDONED

Date Comm. 10-7-55 OCT 26 1955

8 5/8" @ 200/150 DST 3501-17 open

15 min. rec. 5' wm 1110/20"

D & A