


Section 36 Township 1 Range 24 W

Well No. #1 Brown "C"

Company Jones, Shelburne & Farmer

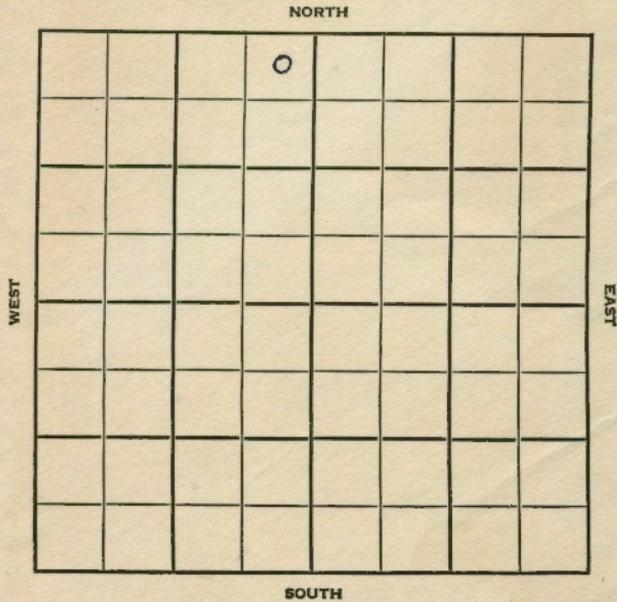

3

SEC. 36	TWP. 1	R. 24W
---------	--------	--------

WELL NO. #1 Brown "C" FAF

COMPANY Jones, Shelburne & Farmer

CONTRACTOR


Wildcat

_____ Ft. from N. Line

_____ Ft. from S. Line

_____ Ft. from E. Line

_____ Ft. from W. Line

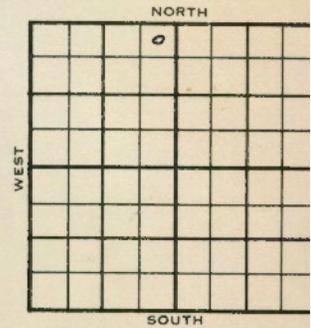

~~Jones~~

NE NE NW

1955	ELEVATION 2386'	REPORT
------	-----------------	--------

10/12 Loc
 11/2 Comm 10-22-55
 8 5/8" @ 190
 H 3315
 L 3362
 BKG 3551
 Gor 3594
 Weathered 3603
 Wash 3604
 TD 3608
 DST 3597-3608 open 1 hr rec 715'
 sw 860# 30"
 D & A

ABANDONED

County Norton Elev. 2386
 Sec. 36 Twp. 1 Rge. 24W
 Company Jones, Shelburne & Farmer
 FarmName J. C. Brown No. 1

Co.

TOPS	DEPTH	LOG	DATUM	Loc. in Sec.
Anh.				NE NE NW
TP.				
H.	3315		929	
Tr.				
Dg.				
BL.				
L.	3362		976	Geol.
K.C.				Contr.
B.K.C.	3551		1165	
Ce.				
C.	3594		1208	
M.				Pool
M.				Wildcat
K.				
Mz.				
Me.				
V.				
S.				
S.				
A	Weather 3603		1217	ABANDONED
R.				
PE.				
G.	Wash 3604		1218	
TD.	3608			

Loc.

No.

Sec.

T.

R.

Date Comm. 10-22-55 NOV 2 1955
8 5/8" @ 190 DST 3597-3608
open 1 hr. rec. 715' sw 860/30"
D & A

County Norton Elev. _____
 Sec. 36 Twp. 1 Rge. 24W
 Company Jones, Shelburne & Farmer
 FarmName Brown "C" No. 1

Co.

TOPS	DEPTH	LOG	DATUM	Loc. in Sec.
Anh.				NE NE NW
TP.				
H.				
Tr.				
Dg.				
BL.				
L.				Geol.
K.C.				Contr.
B.K.C.				
Ce.				
C.				
M.				Pool
M.				Wildcat
K.				
Mz.				
Me.				
V.				
S.				
S.				
A				OCT 12 55 FIRST REPORT
R.				
PE.				
G.				
TD.				

Loc.

No.

Sec.

T.

R.

Date Comm. _____
Location

[Red scribbles]