

The Kansas Geological Survey needs samples from this well for research. If this well penetrates the PreCambrian, the Survey would like to have all the cuttings that contain crystalline samples. This is in addition to the samples normally sent to the Wichita Well Sample Library. *5-1-26w*

IMPORTANT
 samples on this well.


KANSAS DRILLERS LOG

S. 5 T. 1 R. 26 W. *Jul*
 Loc. C N2 SW
 County Decatur

API No. 15 — 039 — 20,471
 County Number

Operator
 Veracruz Petroleum
 Address
 6312 S. Helena Spokane Wash 99203
 Well No. #7 Lease Name Earl Atherton

CONFIDENTIAL
 JUL 8 9 1982

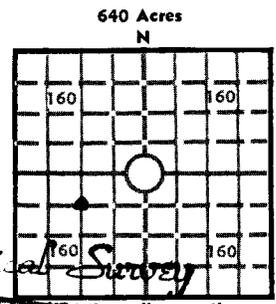

Footage Location
 660 feet from (N) line 1320 feet from (E) line

Principal Contractor J & C Drilling Geologist Green & Green

Spud Date 10 24 79 Total Depth 3558 P.B.T.D.

Date Completed 11-3-79 Oil Purchaser Koch

State Geological Survey
RELEASED
 Date: APR 30 1982
 DE 2474 KB 2475
 FROM CONFIDENTIAL

CASING RECORD

Report of all strings set — surface, intermediate, production, etc.

Purpose of string	Size hole drilled	Size casing set (in O.D.)	Weight lbs/ft.	Setting depth	Type cement	Sacks	Type and percent additives
surface	12	8.625	30	275	poz bulk	90 135	cal cl.
product	7	4.5	9.5	3558	poz	74	

LINER RECORD

PERFORATION RECORD

Top, ft.	Bottom, ft.	Sacks cement	Shots per ft.	Size & type	Depth interval

Size	Setting depth	Packer set at
2 3/8	3550	

ACID, FRACTURE, SHOT, CEMENT SQUEEZE RECORD

Amount and kind of material used	Depth interval treated

INITIAL PRODUCTION

Date of first production 12 1 79	Producing method (flowing, pumping, gas lift, etc.) Pumping			
RATE OF PRODUCTION PER 24 HOURS	Oil 50 bbls.	Gas — MCF	Water 30 bbls.	Gas-oil ratio CFPB
Disposition of gas (vented, used on lease or sold)			Producing interval (s) Regan Sand	

INSTRUCTIONS: As provided in KCC Rule 82-2-125, within 90 days after completion of a well, one completed copy of this Drillers Log shall be transmitted to the State Geological Survey of Kansas, 4150 Monroe Street, Wichita, Kansas 67209. Copies of this form are available from the Conservation Division, State Corporation Commission, 3830 So. Meridian (P.O. Box 17027), Wichita, Kansas 66217. Phone AC 316-522-2206. If confidential custody is desired, please note Rule 82-2-125. Drillers Logs will be on open file in the Oil and Gas Division, State Geological Survey of Kansas, Lawrence, Kansas 66044.

No Data to Be Given out

Operator

DESIGNATE TYPE OF COMP.: OIL, GAS, DRY HOLE, SWDW, ETC.:

Well No.

Lease Name

S _____ T _____ R _____ E _____
W

WELL LOG

Show all important zones of porosity and contents thereof; cored intervals, and all drill-stem tests, including depth interval tested, cushion used, time tool open, flowing and shut-in pressures, and recoveries.

SHOW GEOLOGICAL MARKERS, LOGS RUN, OR OTHER DESCRIPTIVE INFORMATION.

FORMATION DESCRIPTION, CONTENTS, ETC.	TOP	BOTTOM	NAME	DEPTH

USE ADDITIONAL SHEETS, IF NECESSARY, TO COMPLETE WELL RECORD.

Date Received

Signature

Title

Date