
WELL LOG BUREAU—KANSAS GEOLOGICAL SOCIETY
508 East Murdock, Wichita, Kansas

25-1-27W

Company- SAUVAGE & DUNN DRILLING CO.
Farm- Wooley No. 1

SEC. 25 T. 1 R. 27W
NW NW SW

County Decatur
KANSAS

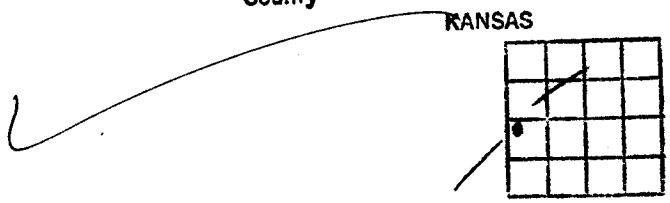

Total Depth. 3707'
Comm. 12-11-55 Comp. 12-22-55
Shot or Treated.
Contractor. Sauvage & Dunn Drlg.
Issued. 8-11-56

Elevation. 2546' RB

CASING:
8 5/8" 245' cem w/150 sx

Production. Dry

Figures indicate Bottom of Formations.

surface casing	245
clay	100
shale	1005
shale & sand	1525
Bittenite & shale	1670
shale & red bed	2025
anhydrite	2040
shale & red bed	2765
shale & lime	2943
lime	2970
shale & lime	3337
lime	3510
shale & lime	3592
lime	3675
Reagan Sand	3700
Granite	3707 RTD
Total Depth	

Tops: Scout	
Heebner	3246
Lansing	3280
Conglomerate	3544
Granite Wash	3670
Granite	3704