


SECTION 1 TOWNSHIP 1S RANGE 27W

WELL NO. #2 Sater

COMPANY D.G. Hanson (Logan)

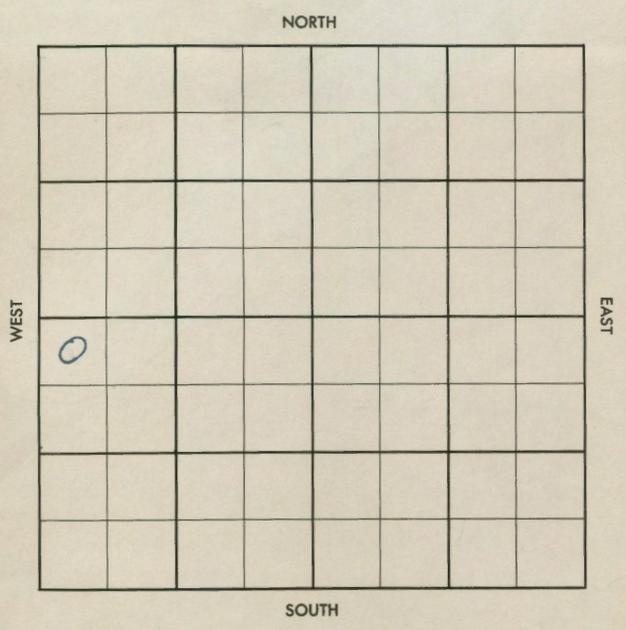

County Decatur Elev. _____
 Sec. 1 Twp. 1S Rge. 27W
 Company D. G. Hanson (Logan)
 FarmName Sater No. 2

TOPS	DEPTH	LOG	DATUM	Loc. in Sec.
Anh.				NW NW SW
Tp.				
H.				
Tr.				
Dg.				
Bl.				
L.				Geol. _____
K.C.				Contr. <u>Cook &</u>
B.M.C.				<u>Galloway</u>
Ce.				<u>rig #1</u>
C.				Pool _____
M.				<u>Warner</u>
M.				
K.				
Mz.				
Me.				
V.				
S.				
S.				
A.				
R.				
Pe.				
G.				
T.B.				

FIRST REPORT
 OCT 3 '56

Date Comm. 9-30-56

Drig. Surf.

(Large red scribble with arrow pointing down)

(Faint red stamp: OCT 1 1956)

(Faint red stamp: R. G.)

op 1 hr see 20' Md BHP 0/20"
 BKC 3466 A sd 3460-76 DST
 3454-77 up 90" see 100' Md.
 (sprk oil) BHP 900/20" Gr wh
 3584 RTD 3600 R19 pipe
 OCT 17 '58 5 1/2 @ 3585/227 at
 Ranlog woct OCT 24 '56 Log Taps
 woct OCT 31 '56 X MIAT CO NOV 7 '56
 18/3461-67 # tst 360 +
 100 Gwph 11 hrs PB 3450
 21/3431-38 No sh 1/2 tst 5
 Goph + 100 Gwph 10 hrs
 PB 3416 18/3328-34 8 Goph
 nolw nat 1/2 \$ 1.12 Boph
 nolw #3411. PB 3319 23/3284
 -92 tst 8 Goph nolw 1/2 \$
 rate 1 1/2 Boph nolw co 3416
 \$ 5 1/2 Boph nolw NOV 13 '56 SD
 NOV 21 '56 NOV 26 '56 DEC 5 '56 DEC 12 '56 DEC 19 '56 DEC 26 '56
 JAN 2 '57 JAN 9 '57 JAN 16 '57 JAN 23 '57
 JAN 30 '57 10 FEB 6 '57 FEB 13 '57 FEB 20 '57

Ph P. 29 Bopd nolw
 gran 34°

1-1-27

new new su

County Decatur Elev. 2564 DF
 Sec. 1 Twp. 13 Rge. 27W
 Company D. G. Hanson (Logan)
 Farm Name Sater No. 2

	TOPS	DEPTH	LOG	DATUM	Loc. in Sec.
Anb.	1938				NW NW SW
Tp. Ser. sd	3265				
H.	3212	3210			
Tr.	3232				
Dg.					
Bl.					
L.	3250	3249			Emmet Elledge Geol.
K.C.	3466	3464			Contr. Cook & Galloway
B.K.C.					Rig #1
Ce.					Pool
C.					Warner
M. A-77	3469-76				
M.					
K.					
Mz. Pennard	3470	3467			
Mo.					
V.					
S.					
S.					
A.					
R.					
PE.					
G. wh	3584	3584			
Tp.	3600				

COMPLETE
 FEB 27 '57

Date Comm. 9-30-56

Drlg. Sump. OCT 10 '56 8 5/8 @ 264/175

Anby 1938 H6 3212 Tr 3232
 Log 3250 DST 3251-70 up 90" see
 20' V50CM BHP 335/20" DST 3280-
 3310 up 90" see 25' Md y oil + 35'
 HMCO BHP 345/20" DST 3328-50
 up 90" see 15' oil + 25' H6 CM BHP
 325/20" DST 3369-88 up 30" see
 4' Md BHP 970/20" DST 3410-22