

KANSAS


FORM 51 5M 10-41 PETROL

Decatur

Section 3 Township 1 Range 27-W

Well No. #1 Savage

Company Helmerich & Payne

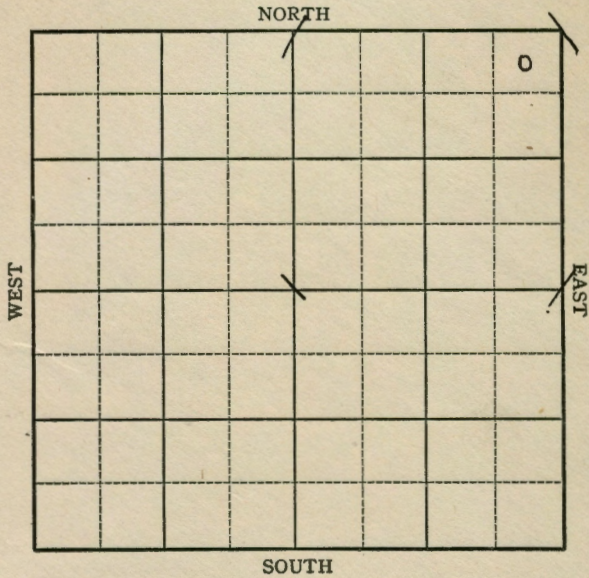

FORM 252-A
5M 9-42 GASS

KANSAS

Decatur

Sec. 3 Twp. 1 R. 27-W

Well No. #1 Savage Farm

Helmerich & Payne Company

Wildcat


330 Ft. from N. Line

_____ Ft. from S. Line

330 Ft. from E. Line

_____ Ft. from W. Line

NE/C Elev. 2612

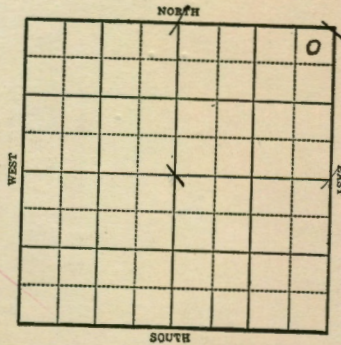

1943

REPORT

2/17 Location Phillips Farm

2/24 Drlg. 1100'

3/3 Anhy 2005
Drlg. 3075

3/8 Top Topeka 3158 - 3154 ?
Top Lansing 3311 - 3307 ?
Porosity and saturation 3324-27
Porosity and saturation 3392 $\frac{1}{2}$ -94
Some porosity and saturation 3424-28
Showing some oil and may carry some water.

Will core ahead (Tel)

3/10 DRILLING REPORT INFORMATION

NOTE: Drilling information does not check with Telephone information

Topeka 3154

Lansing 3307

Sat. & Poro. 3307-11, 3389-93,
3428-33 Water.

Poro. & Sat. 3458-62

Granite wash 3646

Granite 3676

T.D. 3680 $\frac{1}{2}$ ' to Perf. Lansing.

3/17 5" - 3518 RUST

OVER

1943
3/24

Lans 3507
Granite 3676
5" @ 3518'
T.D. 3680 $\frac{1}{2}$ '
60 shots 3310-14
Water.

ABANDONED

KANSAS

Map No. 136 Sec. 3 Twp. 1 R. 27W

Well No. 1 Savage

Helmerich & Payne Company

ABANDONED Contractor

NE/C

SECTION PLAT

330 Ft. from N. Line

Ft. from S. Line

330 Ft. from E. Line

Ft. from W. Line

WILDCAT

Location

RECORD

Rig up

Cased in, ft.

Drilling and Remarks:

Sand

Plan 3807

Gas

Granite 3676

Oil

5" c 3518

Total Depth *3680 1/2*

60 s h to 3310 - 14

PRODUCTION

Water

1st 24 hrs. Nat.

1st 24 hrs. after shot

Gas Cu. Ft.

Dry Hole

Abandoned

Date

MAR 24 1943 19

S. J. LEWIS Scout

KANSAS

Map No. 136 Sec. 3 Twp. 1 R. 27W

Well No. 1 Savage

Helmerich & Payne Company

FIRST REPORT Contractor

NE/C

SECTION PLAT

330 Ft. from N. Line

Ft. from S. Line

330 Ft. from E. Line

Ft. from W. Line

WILDCAT

Location XXX

RECORD

Rig up

Cased in, ft.

Drilling and Remarks:

Sand

Gas

Oil

Total Depth

Phillips Farmout

PRODUCTION

1st 24 hrs. Nat.

1st 24 hrs. after shot

Gas Cu. Ft.

Dry Hole

Abandoned

Date

FEB 17 1943 19

S. J. LEWIS Scout