


KANSAS


SECTION 9 TOWNSHIP 1S RANGE 27W  
WELL NO. #1 Hendricks  
COMPANY C.S.O.

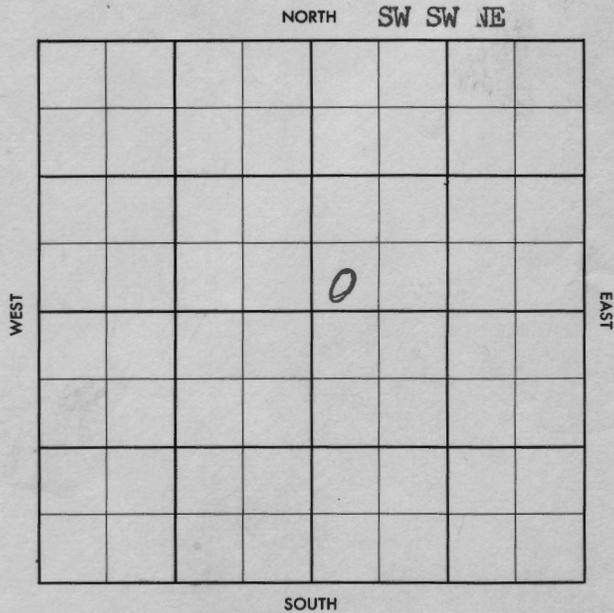

Decatur KANSAS

SEC. 9 TWP. 1 S R. 27 W  
WELL NO. #1 Hendricks  
COMPANY C.S.O.  
CONTRACTOR Lohman & Johnson Tools  
Warner W.

330 FT. FROM N. LINE  
FT. FROM S. LINE  
330 FT. FROM E. LINE  
of C. of Sec. FT. FROM W. LINE  
SW SW NE

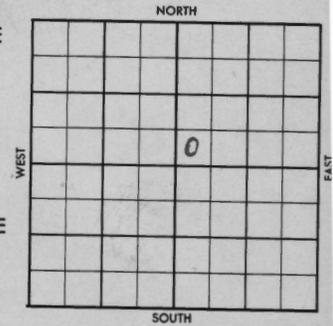

SDX-1/2 Mile

ELEVATION	REPORT
1957	

9/11 Location (FR Tkt)

County Decatur Elev. 2567  
 Sec. 9 Twp. 1S Rgs. 27W  
 Company C. S. O.  
 Farm Name Hendricks No. 1

TOPS	DEPTH	LOG	DATUM	Loc. in Sec.
Ann.	1965			SW SW NE
TP. <u>How</u>	<del>3096</del>	<del>2978</del>	<u>3000</u>	
H. <u>SEV</u>	<u>3088</u>			
Tr.				
Dg.				
Bl.				
L.	<u>3272</u>			Geol.
K.C.				Contr.
B.K.C.	<u>3459</u>			Lohman & Johnson
Ce. <u>Rigan</u>	<u>3612</u>			Tools
C.				Pool
M.				Warner W.
M.				
K.				
Mz.				
Me.				
V.				
S.				
S.				
A.				
R.				
Pe.				
G.	<u>3624</u>			ABANDONED
G.	<u>3637</u>			
TD.	<u>3642</u>			

SEP 25 '57  
 0  
 ABANDONED

Date Comm. 1/2 Mile  
 Location 300' E 330' N C. of Sec.  
 SP 9-12 - 8" 320/252  
 # 3096 SEP 25 '57 DST 3273-95  
 30" 8' M BH 80/30" DST 3316-70  
 1hr 37' M BH 775/30" DST 3425  
 -20 1hr 10' M BH 90/30" DST  
 3602-16 1hr 785 M SW BH 935/90  
 D & A

County Decatur Elev. \_\_\_\_\_  
 Sec. 9 Twp. 1S Rgs. 27W  
 Company C. S. O.  
 Farm Name Hendricks No. 1

TOPS	DEPTH	LOG	DATUM	Loc. in Sec.
Ann.				SW SW NE
TP.				
H.				
Tr.				
Dg.				
Bl.				
L.				Geol.
K.C.				Contr.
B.K.C.				Lohman & Johnson
Ce.				Tools
C.				Pool
M.				Warner W.
M.				
K.				
Mz.				
Me.				
V.				
S.				
S.				
A.				
R.				
Pe.				
G.				
TD.				

FIRST REPORT  
 SEP 14 '57

Date Comm. SDX-1/2 MILE  
 Location 300' E 330' N C. of Sec.