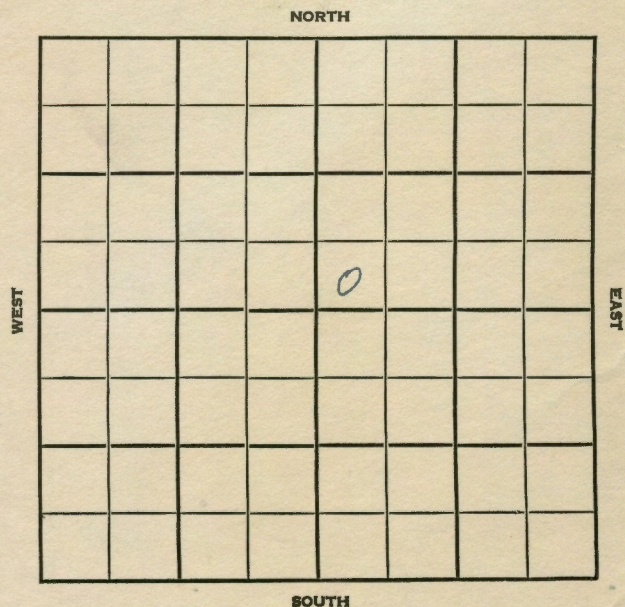


Section 11 Township 1 Range 27WWell No. #1 SaterCompany Cities Service

7

11 1 27W

WELL NO.

#1 Sater

COMPANY

Cities Service

CONTRACTOR

L & J

Warner


_____ FT. FROM N. LINE

_____ FT. FROM S. LINE

_____ FT. FROM E. LINE

_____ FT. FROM W. LINE

SW SW NE

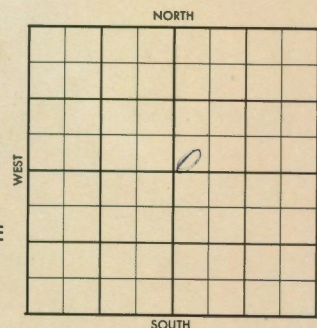

1956

ELEVATION

2531'

REPORT

7-11

Location

8-15

Comm. 7-21-56

8 5/8" @ 320 w/250

DST 2924-3000 op 1 hr, rec. 35' mud, 790/30".

DST 3112-60 op 1 hr., rec. 48' mud, 945/30".

DST 3194-3253 op 1 hr., rec. 245'

VHOCM / 180' Hvy oil, 1055/30".

DST 3276-3328 op 1 hr., rec. 110' MSW, 850/30".

DST 3350-93 op 1 hr., rec. 20' mud, BHP 60/20".

5 1/2" @ 3420 w/200

CO 3402; 33/3306-14; 41/3186-96;

37/3227-36;

FU 778' oil / 92' wtr., 13 hrs.

P/ 9 boph / 18% wtr., 6 hrs.,

P/ 497 BO / 26 BW, 24 hrs.

Anh. 1888'; How. 2923'; Tp. 3027';

Hb. 3150'; Dodge 3174'; L. 3192';

BKC 3402';

Log tops: L. 3189';

TD 3420'

COMPLETED

11-1-27W

AN SW W

AUG 8 '56

CO 3402 33/3306-14

41/3186-96 37/3222-36 PU

778' oil + 92' water 13 hrs

N. 3306-14 (DB PKR) R.

9 Bore + 18.70 water 6 hrs

AUG 15 '56

Ph P. 497 BO + 26

BW 24 hrs.

11-1-27 W

SW SW W

County

Decatur

Elev.

2531

Sec.

11

Twp.

1

Rge.

27W

Company

Cities Service

Farm Name

Gater

No.

1

TOPS	DEPTH	LOG	DATUM	Loc. in Sec.
Anh.	1888			SW SW 101
Tp.	How 2923			
H.	TP 3027			
Tr.	H6 3150			
Dg.	Dodge 3174			
Bl.				
L.	3192	3189		
K.C.				Geol.
B.K.C.	3402			Contr.
Ce.				L & J
C.				
M.				Pool
M.				Warner
Mz.				
Mq.				
V.				
S.				
S.				
A.				
R.				
Pe.				
G.				
TD	3420			COMPLETE

Date Comm.

AUG 15 '56

Location JUL 18 '56

Loc. JUL 25 '56

7-21-56

878 320/250 ID 2860 AUG 1 '56

DST 2924-3000 1 hr 35' Md

790/30" DST 3112-60 1 hr 48'

Md 945/30 DST 3194-3253 1 hr

245' VHO CM + 180' Hwy oil 1055/30"

DST 3276-3328 1 hr 110' MSW

850/30" DST 3350-93 1 hr 20' Md

BHP 60/24 5 1/2 3420/200

33

County <u>Decatur</u>		Elev. _____		Co.
Sec. <u>11</u>	Twp. <u>1</u>	Rgs. <u>27W</u>		
Company <u>Cities Service</u>				
Farm Name <u>Sater</u>		No. <u>1</u>		

TOPS	DEPTH	LOG	DATUM	Loc. in Sec.
Anh.				SW SW NE
Tp.				
H.				
Tr.				
Dg.				
Bl.				
L.				Geol. _____
K.C.				Contr. _____
B.K.C.				L & J
Ce.				
C.				
M.				Pool
M.				Warner
K.				REPORT JUL 11 '55
Mz.				
Ma.				
V.				
S.				
S.				
A.				
R.				
Pe.				
G.				
T.D.				

Date Comm. _____

Location _____

JUL 11 1955

G.R.

No. _____

Sec. _____

T. _____

R. _____