


Decatur

KANSAS
27W

SECTION 11 TOWNSHIP 1 RANGE 27W

WELL NO. #1 Sater

COMPANY C.S.O.

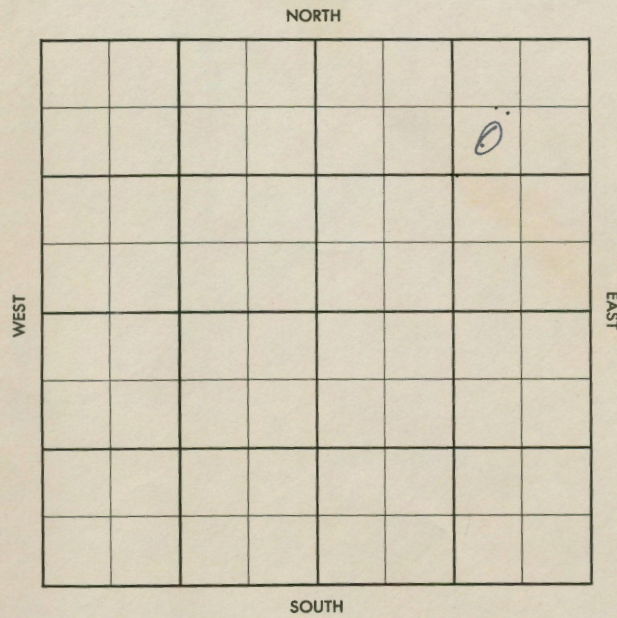

County Decatur Elev. 2567
 Sec. 11 Twp. 1 Rgs. 27W
 Company C. S. Co.
 Farm Name Sater No. 4

TOPS	DEPTH	LOG	DATUM	Loc. in Sec.
Anh.				SW NE NE
Tr.				
H.				
Tr.				
Dg.				
Bl.				
L.				Geol.
K.C.				
B.K.C.				Contr.
Ce.				I. & J Tools
C.				Pool
M.				Warner
K.				SEP 26 56
Mz.				
Me.				
V.				
S.				
S.				
A.				
R.				
P.				
G.				
T.D.				

Date Comm. spd 9-22-56

8" @ 320 w/250, Drlg. 2595

3301 0 1 TCO

R.G.

+ 140 oil 1145/30" DST 3431
 -53 1hr 24'50CM +1' oil BHP
 325/30" 5 1/2 3467/200 OCT 10 '56
 Co 25/3419-25 41/3405-11
 37/3379-88 FU 540' oil +1103'
 Wt 19 hrs OCT 17 '56 P. 9 1/2 BO
 + 22 BW 24 hrs 1 1/2 P
 302 BO + 26 BW in 16 hrs
 PB 3365 OCT 24 '56 33/3345-53
 13/3340-43 13/3278-81 33/3267
 -75 13/3257-60 21/3225-35
 3hr & 159 BO + 10 BW 24 hrs
 Co 3457 OCT 31 '56 P. 184 BO +
 31 BW 16 hrs NOV 7 '56 Ph P.
 280 Bopd + 1090 Wt
 grav 34°

11-1-27

aw ne ne

County Decatur Elev. 2567
 Sec. 11 Twp. 1 Rge. 27W
 Company C. S. O.
 Farm Name Sater No. 4

	TOPS	DEPTH	LOG	DATUM	Loc. in Sec.
Anh.					SW NE NE
Tp.	How	2960			
H.	304	3043			
Tr.	TP	3063			
Dg.	48	3187			
Bl.	Dodge	3210			
L.		3226			
K.C.					Geol.
BXC.		3442			
Co.	Penns	3446-50			Contr.
C.					L & J Tools
M.					
M.					Pool
K.					Warner
M.					
Mo.					
V.					
S.					
S.					
A.					
R.					
Pe.					
G.					
TD.		3468			

Date Comm. spd 0-22-56

8" @ 320 w/250, Drlg. 2595 OCT 3 '56

DST 3173-3200 1hr 25' Md BHP
 990/30 DST 3227-50 1hr 10'
 MCO + 20' OCM 880/30 DST
 3258-85 1hr 10' OCM + 27' oil
 BHP 610/30 DST 3342-65 1hr
 11' oil + 30' HOCM BHP 965/30"
 DST 3386-95 1hr 3' Md BHP
 21/30 DST 3403-27 1hr 30' OCM