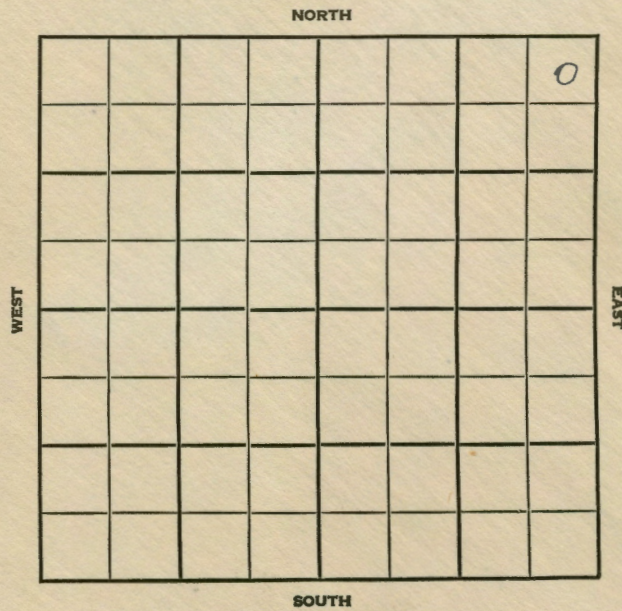


Section 11 Township 1 Range 27WWell No. #6 SaterCompany C.S.O.

3417-38 1hr 6' Md BHP
 105/30" 5 1/2 @ 3449/600 NOV 13 '56
 CO 3434 21/3338-43 37/3298
 3307 21/3269-74 41/3254-64
 45/3216-27 tst 178 60 + 22
 gw in 18 hrs 15 tst 116
 B0+5 BW in 24 hrs P.
 140 Bopd + 370 wtr, NOV 21 '56
 PL P. 225 Bopd + 170 wtr

11-1-27

ne ne ne

County	Decatur		Elev.	2563
Sec.	11	Twp.	1	Rge.
Company	C. S. O.			
Farm Name	Sater		No.	6

TOPS	DEPTH	LOG	DATUM	Loc. in Sec.
Anb.				NE NE NE
Tr.	3044			
H.	3176			
Tr.	Dodge	3198		
Dg.				
BL.				
L.	3214			
K.C.				Geol.
B.K.C.				Contr.
Ce.				Lohmann & John
C.				son Tools
M.				Pool
M.				Warner
V.				
S.				
A.				
R.				
Pe.				
S.				
TD	3450			

Date Comm. spd. 10-25-56
 8" @ 320 w/250, How 2958, Severy Sd 3030,
 Drlg. 3050 NOV 7 '56 DST 3215-40 1hr.
 20' HOCM + 10' oil 990/30" DST
 3257-75 1hr 10' OCM + 15' oil
 790/30" DST 3298-3320 1hr
 40' HOCM 1025/30" DST 3329-50
 1hr 2' Md 240/30" DST 3370-80
 1hr 3' Md BHP 0/30" DST 3396
 -3415 1hr 2' Md 30/30" DST

COMPLETE

FORM 513 SUNRAY

County Decatur Elev. _____
 Sec. 11 Twp. 1 Rge. 27W
 Company C. S. O.
 Farm Name Sater No. 6

TOPS	DEPTH	LOG	DATUM	Loc. in Sec.
Anh.				NE NE NE
TP.				
H.				
Tr.				
Dg.				
BL.				
L.				Geol. _____
K.C.				Contr. _____
B.K.C.				Lohmann & John
Ce.				son Tools
C.				Pool
M.				Warner
K.				
Mz.				
Me.				
V.				
S.				
S.				
A.				
R.				
Pe.				
G.				
TP.				

FIRST REPORT
 00 31 56

Date Comm. spd. 10-25-56
8" @ 320 w/250, How 2958, Severy Sd 3030,
Drlg. 3050

NOV 5 1956
 R. G.

33

No. Sec. T. R.