


SECTION 11 TOWNSHIP 1 RANGE 27W
 WELL NO. #4 Warner "E"
 COMPANY Cities Service

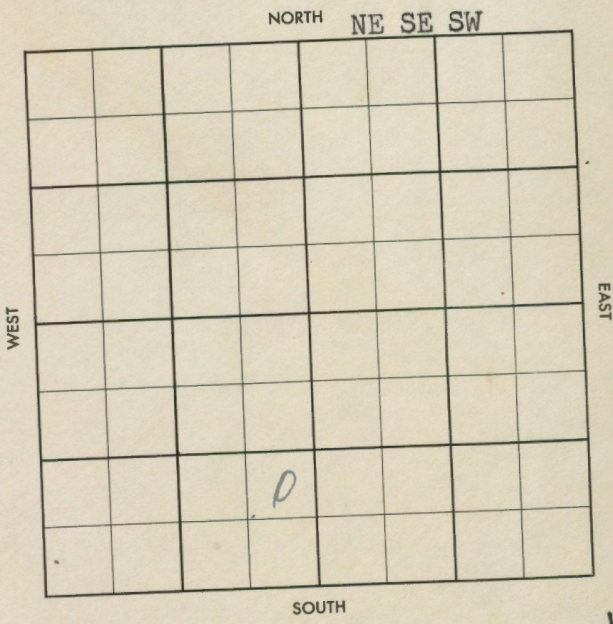

FORM 519 SUNRAY

~~County Decatur Elev. _____~~
~~Sec. 11 Twp. 1 Rge. 27W~~
~~Company Cities Service~~
~~Farm Name Warner "E" No. 4~~

TOPS	DEPTH	LOG	DATUM	Loc. in Sec.
Anh.				NE SE SW
Tp.				
H.				
Tr.				
Dg.				
Bl.				
L.				Geol. _____
K.C.				Contr. <u>Lohmann &</u>
B.K.C.				<u>Johnson</u>
Ce.				Pool _____
C.				<u>Warner</u>
M.				
M.				
K.				
Mz.				
Me.				
V.				
S.				
S.				
A.				
R.				
Pe.				
G.				
T.D.				

Date Comm. 8-12-57
8" @ 320/250, WOC

AUG 14 57
 FIRST REPORT

~~33~~

-55 lhr 4' Md 350/20 DST
 3367-85 lhr 8' Md 880/30
 5 1/2 3399 SEP 11 57 154/3160 - 3263
 4250 Acd P 69 B0 + 7BW
 for 8 hrs P 207 B0 + 28W

County Decatur Elev. 2496 D
 2496
 Sec. 11 Twp. 1 S Rge. 27W
 Company Cities Service
 FarmName Warner "E" No. 4-A

	TOPS	DEPTH	LOG	DATUM	Loc. in Sec.
Anh.	How	2899			NE SE SW
Tp.	SEV	2926			
H.	TP	3004			
Tr.	H8	3115			
Dg.	Dodge	3144			
Bl.					
L.		3154			
K.C.					Geol.
B.K.C.					Contr. Lohmann &
Ce.					Johnson
C.					
M.					Pool
M.					Warner
K.					
Mz.					
Mo.					
V.					
S.					
A.					
R.					
PE.					
G.					
TR.	3400	165			

COMPLETE
 SEP 11 57

Date Comm. 8-12-57
 8" @ 320/250, WOC AUG 21 57 1650 feet lin
 1st 1st 5Kid 105' North. AUG 28 57
 8-20-57 85/8 320/250
 DST 315.5-80 lhr 30' 50CM + 8'
 oil 900/30" DST 3189-3215 lhr
 20' oil + 15' HOEM BHP 516/30
 DST 3234-60 lhr 45' oil + 40'
 HOEM 805/30" DST 3272-90
 20" 3' MW BHP SEP 4 57 DST 3311

11-1-29