


Section 12 Township 1 Range 27W

Well No. #3 Sater

Company D.G. Hansen

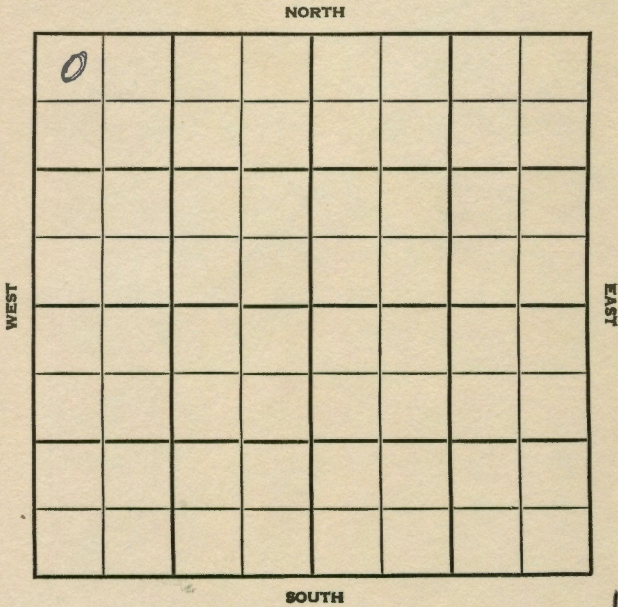

FORM 513 SUNRAY

County Decatur Elev. \_\_\_\_\_  
 Sec. 12 Twp. 1 Rge. 27W  
 Company D. G. Hansen  
 Farm Name Sater No. 3

TOPS	DEPTH	LOG	DATUM	Loc. in Sec.
Anh.				NW NW NW
Tp.				
H.				
Tr.				
Dg.				
Bl.				
L.				Geol. _____
K.C.				
B.K.C.				Contr. _____
C.				Cook & Gallo-
M.				way Tools
M.				Pool
K.				Warner
Mz.				
Mo.				
V.				
S.				
S.				
A				
R.				
PE.				
G.				
TR.				

0  
 NOV 21 '56  
 FIRST REPORT

Date Comm. \_\_\_\_\_

Location \_\_\_\_\_

93  
22

+ 30' VHO CM BHP 1005/20" DST  
 3399-2421 1/2 in 25' VHO CM  
 BHP 685 5/2 3455/220 DEC 12 '56  
 WOCT DEC 19 '56 DEC 26 '56 JAN 2 '57 MICT  
 JAN 9 '57 CO 21/3396-3403 21/  
 3374-81 1/2 8 to 10 Boph  
 JAN 15 '57 PB 3364 36/3322-44  
 1/2 +ST 5 Boph  
~~P.P. 34~~ JAN 30 '57 CO 3423  
 Pof FEB 6 '57 FEB 13 '57 FEB 20 '57 FEB 27 '57  
 Ph P. 30 Bopd 590 wt  
 gran 34°

12-1-27

mw mw mw

County Decatur Elev. 2546 DP  
 2550 RB  
 Sec. 12 Twp. 1 Rgn. 27W  
 Company D. C. Hansen  
 Farm Name Sater No. 3

TOPS	DEPTH	LOG	DATUM	Loc. in Sec.
Anh.	1927			NW NW NW
TP.	3049			
H.	3180			
Tr.	3205			
Dg.				
Bl.				
L.	3218			Geol.
K.C.				
B.K.C.	3431			Cook & Gallo
Ce.				any Tools
C.	Pennsd 3436			Pool
M.				Warner
M.				
Me.				
V.				
S.				
S.				
A.				
R.				
Pe.				
G.				
TD.	3460			COMPLETE FEB 27 '57

Date Comm. NOV 28 '56 11-21-56 85/8  
 296/220 M 2889 Dec 5 '56  
 DST 3218-45 1/2 in 19' 0 CM + 1' Free  
 oil 1720/20 DST 3259-85 30"  
 8' 0 CM BHP 510/30 DST 3201  
 -25 1/2 in 40' HO CM BHP 865/30"  
 DST 3335-59 1/2 in 285' 9 CM  
 45' oil + 90' 50 CM BHP 245/20  
 DST 3372-72 1/2 in 20' Mdy oil