

**WELL COMPLETION REPORT AND DRILLER'S LOG**

API No. 15 — 039 — 20,521  
County Number

Loc. NE SW SE

County Decatur

Operator  
F & M Oil Co., Inc.

Address  
422 Union Center, Wichita, Kansas


Well No. 1 Lease Name Moore "A"

Footage Location  
990 feet from (N) (S) line 1650 feet from (E) (W) line

Principal Contractor Abercrombie Drilling Geologist Bob Jenkins

Spud Date 7-10-80 Date Completed 7-17-80 Total Depth 4250 P.B.T.D.

Directional Deviation ----- Oil and/or Gas Purchaser

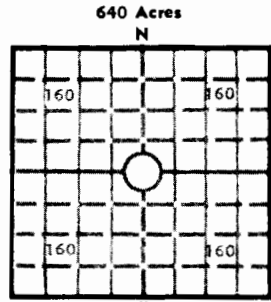

Locate well correctly

Elev.: Gr. 2743

DF KB 2751

**CASING RECORD**

Report of all strings set— surface, intermediate, production, etc.

Purpose of string	Size hole drilled	Size casing set (in O.D.)	Weight lbs/ft.	Setting depth	Type cement	Sacks	Type and percent additives
surface	12 1/4"	8-5/8"		301	common	250	2% gel, 3% CC

**LINER RECORD**

**PERFORATION RECORD**

Top, ft.	Bottom, ft.	Sacks cement	Shots per ft.	Size & type	Depth interval

**TUBING RECORD**

Size	Setting depth	Packer set at

**ACID, FRACTURE, SHOT, CEMENT SQUEEZE RECORD**

Amount and kind of material used	Depth interval treated

**INITIAL PRODUCTION**

Date of first production		Producing method (flowing, pumping, gas lift, etc.)			
<b>RATE OF PRODUCTION PER 24 HOURS</b>	Oil	Gas	Water	Gas-oil ratio	
	bbls.	MCF	bbls.	CFPB	
Disposition of gas (vented, used on lease or sold)			Producing interval(s)		

INSTRUCTIONS: As provided in KCC Rule 82-2-125, within 90 days after completion of a well, one completed copy of this Drillers Log shall be transmitted to the State Geological Survey of Kansas, 4150 Monroe Street, Wichita, Kansas 67209. Copies of this form are available from the Conservation Division, State Corporation Commission, 245 No. Water, Wichita, Kansas 67202. Phone AC 316-522-2206. If confidential custody is desired, please note Rule 82-2-125. Drillers Logs will be on open file in the Oil and Gas Division, State Geological Survey of Kansas, Lawrence, Kansas 66044.

Operator  
F & M Oil Co., Inc.

DESIGNATE TYPE OF COMP.: OIL, GAS,  
DRY HOLE, SWDW, ETC.:  
dry

Well No.  
1

Lease Name  
Moore "A"

S 29 T 1 R 29 ~~EX~~  
W

**WELL LOG**

Show all important zones of porosity and contents thereof; cored intervals, and all drill-stem tests, including depth interval tested, cushion used, time tool open, flowing and shut-in pressures, and recoveries.

SHOW GEOLOGICAL MARKERS, LOGS RUN,  
OR OTHER DESCRIPTIVE INFORMATION.

FORMATION DESCRIPTION, CONTENTS, ETC.	TOP	BOTTOM	NAME	DEPTH
NO DST's			Electric Log Anhydrite Heebner Lansing B/KC Arbuckle LTD	Tops: 2450 (+ 301) 3669 (- 918) 3716 (- 965) 3950 )-1199) 4235 (-1484) 4249

USE ADDITIONAL SHEETS, IF NECESSARY, TO COMPLETE WELL RECORD.

Date Received

*C. A. Jacobson*  
Signature

President  
Title

7-23-80  
Date