


SECTION 29 TOWNSHIP 1 RANGE 29W

WELL NO. #1 Campbell

COMPANY Jones, Shelburne & Farmer

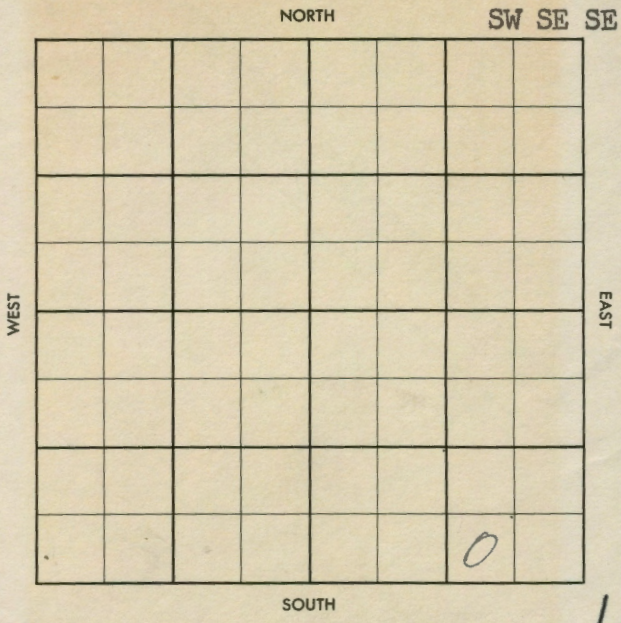

16

SEC. 29 TWP. 1 S R. 29 W


WELL NO. #1 Campbell

COMPANY Jones, Shelburne & Farmer

CONTRACTOR

Wildcat

- _____ FT. FROM N. LINE
- _____ FT. FROM S. LINE
- _____ FT. FROM E. LINE
- _____ FT. FROM W. LINE

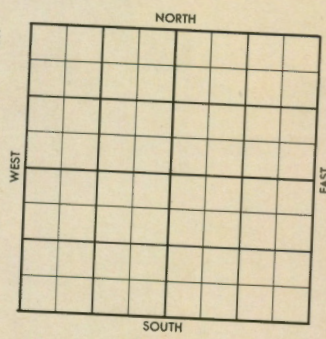

SW SE SE
SDX-1/2 Mile
Phillips-AC & DHM

1957 ELEVATION REPORT

5/1 MIRT

(FR Tkt)

WILDCAT

FORM 513 SUNRAY

County Decatur Elev. _____
 Sec. 29 Twp. 1 Rge. 29W
 Company Jones, Shelburne & Farmer
 Farm Name Campbell No. 1

TOPS	DEPTH	LOG	DATUM	Loc. in Sec.
Anh.				SW SE SE
Tr.				
H.				
Tr.				
Dg.				
Bl.				
L.				
N.C.				Geol.
B.K.C.				Contr.
Ce.				
C.				
M.				Pool
Mz.				Wildcat
Mo.				<div style="border: 1px solid black; padding: 2px;"> <p><u>1/2 mile</u></p> <p>FIRST REPORT</p> <p>MAY 1 57</p> </div>
V.				
S.				
A.				
R.				
Pe.				
G.				
TR				

Date Comm. Phillips (AC) & (DHM)

M I R T

33

M.M

3B-M

16

FORM 513 SUNRAY

County Decatur Elev. 2691
 Sec. 29 Twp. 1 Rge. 29W
 Company Jones, Shelburne & Farmer
 Farm Name Campbell No. 1

TOPS	DEPTH	LOG	DATUM	Loc. in Sec.
Dg.				SW SE SE
Bl.				
L.	<u>3660</u>			
N.C.				Geol.
B.K.C.	<u>3905</u>			Contr.
Ce.				
C.	<u>4137</u>			
M.				Pool
Mz.				Wildcat
Mo.				<div style="border: 1px solid black; padding: 2px;"> <p>MAY 15 57</p> <p>ABANDONED</p> </div>
V.				
S.				
A.	<u>4145</u>			
R.				
Pe.				
G.				
TR	<u>4180</u>			

Date Comm. Phillips (AC) & (DHM)

M I R T MAY 15 57 5-1-57 85/8/62
1115 17 3605 MAY 15 57 DST 3666-
77 op 1 in 300' SW BHT
800/20"

DEA