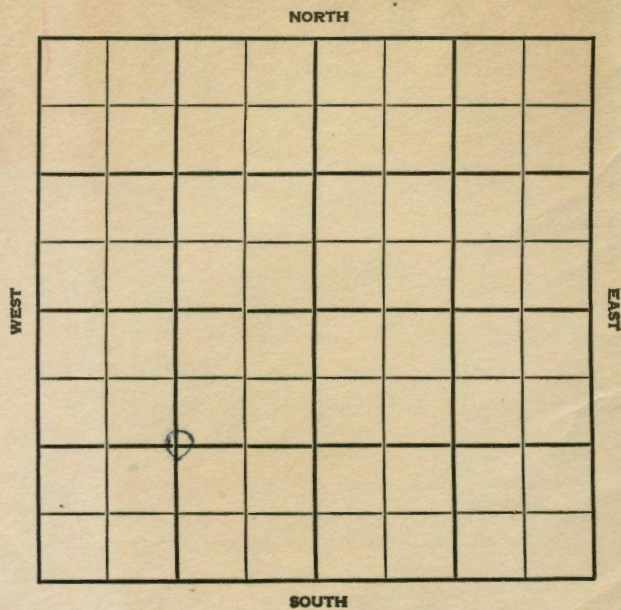


Section 18 Township 1 Range 31WWell No. #1 SlokoCompany Columbian Fuel

11

SEC. 18 TWP. 1 R. 31 WWELL NO. # 1 Sloko FARMCOMPANY Columbian FuelCONTRACTOR Mid-WesternWildcat


Ft. from N. Line

1320 Ft. from S. Line

Ft. from E. Line

1320 Ft. from W. Line

C SW/4

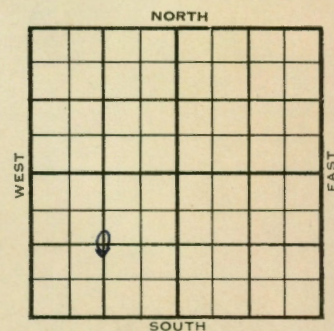1954 ELEVATION - REPORT

10/27 Drlg. Strat Test

11/3 Spud 10-17-54


8" @ 321'

TD 2521'

D & A

ABANDONED

County Rawlins State Kansas
 Sec. 18 (Blk. 1 (Sur. 31W Map No.
 Operator Columbian Fuel
 Well No. 1 Farm Sloko
 Elev. Location C SW/4

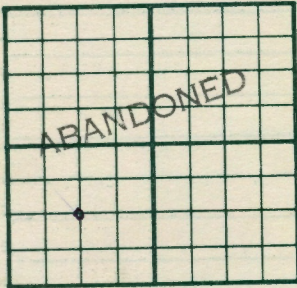

1320 Ft. From S Line SW
1320 Ft. From W Line Quarter
 1st. Report
 Completion NOV 3 1954
 Remarks Wildcat
Midwestern - Contr.
 Spudding Date 10-17-54

Drlg. Data

8" @ 321 TD 2521 D & A

FABEN GILSTRAP

County Rawlins State Kansas
 Sec. 18 (Blk. 1 (Sur. 31W Map No.
 Operator Columbian Fuel
 Well No. 1 Farm Sloko
 Elev. Location C SW/4



1320 Ft. From S Line SW
1320 Ft. From W Line Quarter
 1st. Report OCT 27 1954
 Completion
 Remarks Strat test
Midwestern - Contr.
 Spudding Date

Drlg. Data

Wildcatdrlg.

FABEN GILSTRAP