



LAUGHLIN-SIMMONS & CO. OF KANSAS, INC.  
OIL FIELD SURVEYING  
1337 NORTH MERIDIAN, SUITE 2 (316) 943-5351  
WICHITA, KANSAS 67203

KE504842  
INVOICE NO.

HOFF OIL & GAS  
OPERATOR

1  
NO.

Sylvia "J"  
FARM

Rawlins  
COUNTY

28 1s 33w  
S T R

350' FSL 1320' FWL NE/4  
LOCATION

ELEVATION: 2983gr




HOFF OIL & GAS  
P. O. Box 97  
Lance Creek, Wyoming 82222

AUTHORIZED BY

SCALE 1" = 1000'

1 mile E  
9 miles N to  
"ATWOOD"

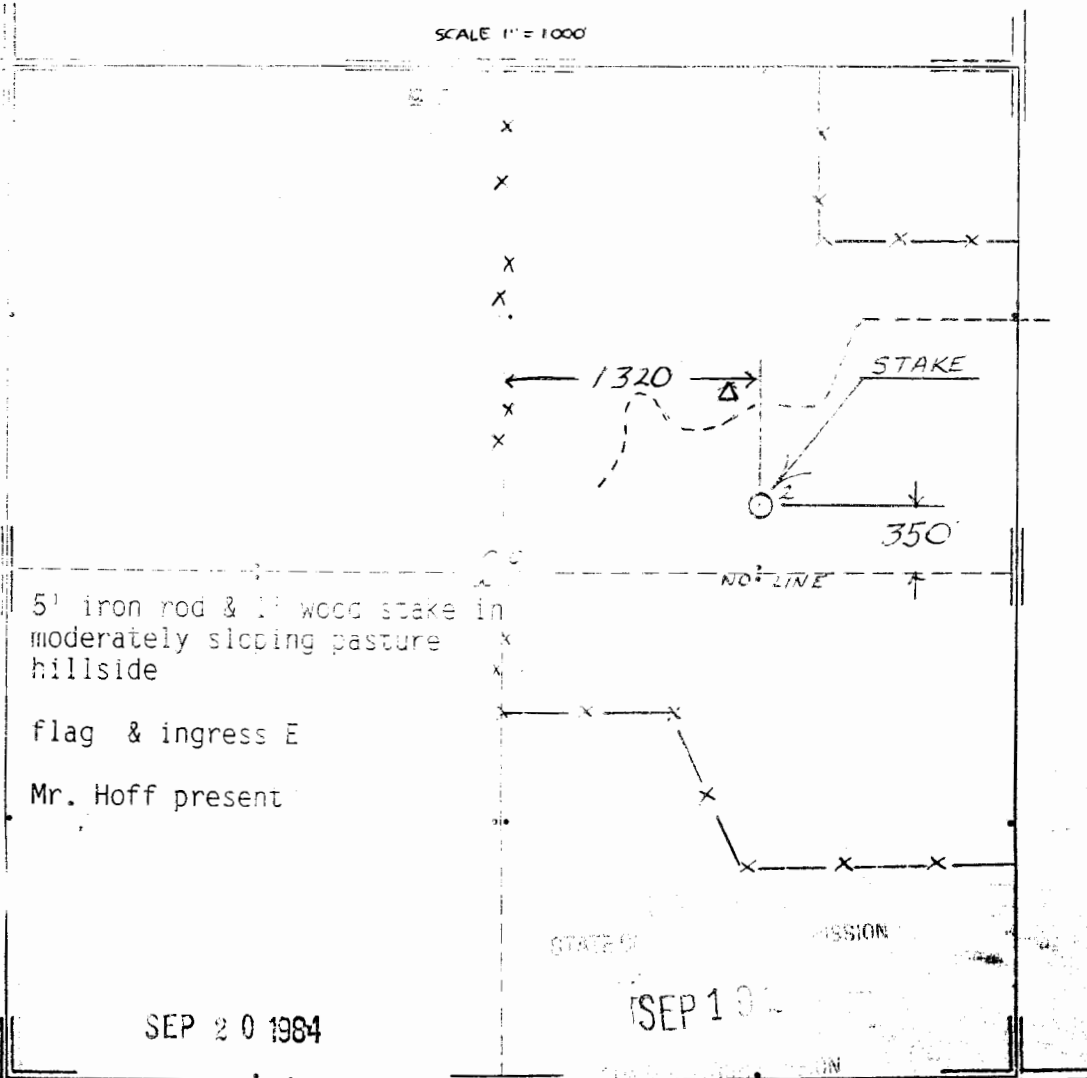

5' iron rod & 1" wood stake in  
moderately sloping pasture  
hillside

flag & ingress E

Mr. Hoff present

SEP 20 1984

SEP 1 1984

State Geological Survey  
WICHITA BRANCH