


FORM 51 25M 8-50 WESTERN Cheyenne KANSAS  
 Section 26 Township 1 Range 39 W  
 Well No. # 1 Judy Est.  
 Company Ben Brack Oil

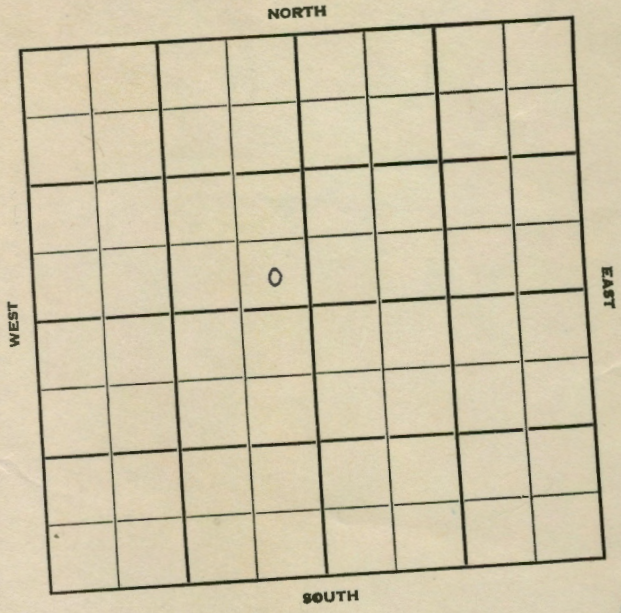


6

10M 11-80 PETROL Cheyenne KANSAS  
 Sec. 26 Twp. 1 R. 39 W ✓  
 Well No. # 1 Judy Est. Farm  
Ben Brack Oil Company

Brack Oil Contractor  
Wildcat-Seismograph

\_\_\_\_\_ Ft. from N. Line  
330 Ft. from S. Line  
330 Ft. from E. Line  
 \_\_\_\_\_ Ft. from W. Line

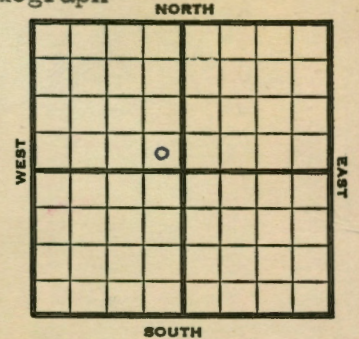

SE SE NW  
 Ohio farmout & DHM

1951	Elev. 3114'	REPORT
		Arb. test
3/28		Cellar & pits
5/3		Topeka 3955' Lansing 4180' DST. 4180'-95' - TD. ? Rec. 30' oil cut mud in 30 minutes after circulating for 48 hrs. BHP. 1340# Shut down, motor repairs. Gulf
		Tight hole
		Still working over the well Made 222 oil last 7 days and 440 water. Estimate 20 bbl well from lansing
1952		
2/5		5½" @ 4754 TRD 5141 P 5 BO & 10 BWPD
2/12		No report
2/20		"
3/5		"
3/12		Spud 4-6-51 Oil Well TD 4550' 10" @ 124 Niobrara 1078 Ft. Hays 1568 Carlyle 1614 Codell 1623-55 Greenhorn 1816-1908 1st Granerour sd 1967 Silt & sale 2040 Dakota 2410 Fuson 2446
		OVER

1952

3/12

Lakota 2455 Morrison 2526  
B. Morr. 2625-63 Permian 2790  
Day Creek 2810-60 Blaine 2910-50  
Stone Corral 3110-60  
Wellington 3300 Chase 3690  
Top. 3955 Dodge 4125  
KC 4180 Marm. 4305  
Cong. 4630 Chert 4848  
Arb. 5015-5141

5" @ 4754'

DST 4180-95 open 1/2 hr. rec. 30' OCM

DST 4515-40 open 1 hr. rec. 30' HOCM

45' SO&GCM

DST 4796-4803 open 45 min. rec. 30'

VSGCM CO to 4720

17/ 4587-95 22/ 4480-88

22/ 4488-96 500 A  $\frac{1}{2}$  bo

72/ 4496-4508 22/ 4481-87

?/ 5 goph 24/ 4487-93 7 go 1 bwph

1500 A S/ 15 bo 148 bw 7 hr.

24/ 4287-92 40/ 4145-49  $\frac{1}{2}$  bo

15 bwph 16/ 4149-53 B/ 10 gcm & oil

24/ 4146-52 16/ 4155-59 500 A

2500 A  $7\frac{1}{2}$  boph  $6\frac{1}{2}$  bwph CO to 4721

96/ 4566-78 24 bw 5 hr. 192/ 4502-14

500 A 6 bo 21 bw 6 hr. 129/ 4497-

4507 P/ 2 bo 7 bw SP 4455 4000 A

10000 A S/ 23 bo 21 bw 9 hr.

SP 4380 24/ 4356-62 500 A

96/ 4146-58 500 A SSO CO to 4380

DP to 4550  $5\frac{1}{2}$  bw  $\frac{1}{2}$  boph

Comp. 5 bopd 10 bw

COMPLETED



Dirig. Data

17/ 4587-95    22/ 4480-88    22/ 4488-96  
500 A  $\frac{1}{2}$  bo    72/ 4496-4508    22/ 4481-87  
B/ 5 goph    24/ 4487-93    7 go 1 bwph  
1500 A    S/ 15 bo    148 bw    7 hr.  
24/ 4287-92    40/ 4145-49     $\frac{1}{2}$  bo    15 bwph  
16/ 4149-53    B/ 10 gcm & oil    24/ 4146-52  
16/ 4155-59    500 A    2500 A    7 $\frac{1}{2}$  boph  
6 $\frac{1}{2}$  bwph    CO to 4720    96/ 4566-78  
2 $\frac{1}{2}$  bw 5 hr.    192/ 4502-14    500 A  
6 bo 21 bw 6 hr.    129/ 4497-4507  
P/ 2 bo 7 bw    SP 4455    4000 A    10000 A  
S/ 23 bo 21 bw 9 hr.    SP 4380  
24/ 4356-62    500 A    96/ 4146-58  
500 A    SSO    CO to 4380    DP to 4550  
5 $\frac{1}{2}$  bw     $\frac{1}{2}$  boph  
Comp. 5 bopd    10 bw

MAR 18 1952

Scout Cards
and Small Map
and Wall Map
Tracings
France Map
Police Map
Misc.