


Section 19 Township 1 Range 7W

Well No. 1 Glen Roe

Company National Association

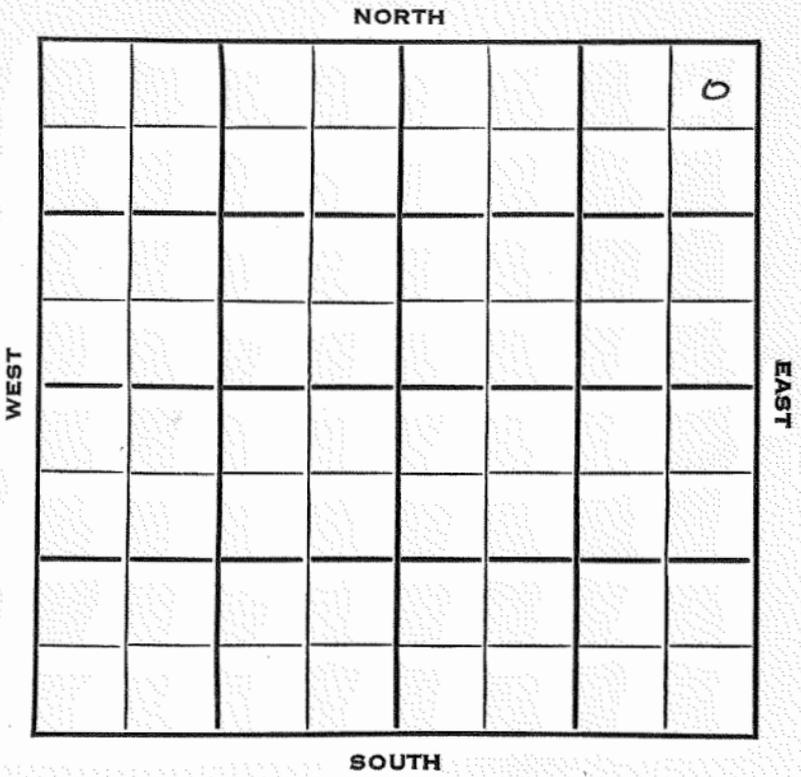

Jewell

KANSAS ✓

Sec. 19 Twp. 1 R. 7W

Well No. #1 Glen Roe Farm \_\_\_\_\_

National Assoc. Company \_\_\_\_\_

Wildcat Contractor \_\_\_\_\_


330 Ft. from N. Line

\_\_\_\_\_ Ft. from S. Line

330 Ft. from E. Line

\_\_\_\_\_ Ft. from W. Line

NE NE NE  
Tight Hole

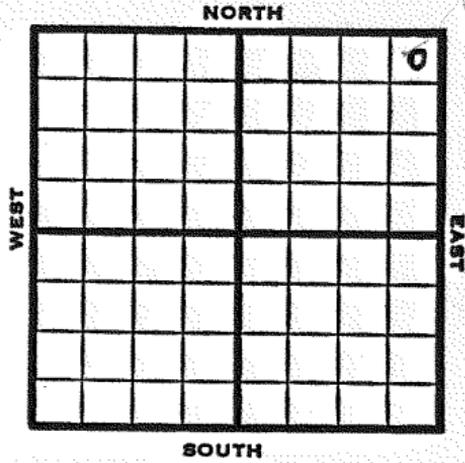

1953 Elev. 1725' REPORT

- 1/14 Location
- 1/22 Drlg.
- 1/29 Drlg. 3889'
- 2/5 TD 4120' D & A
- 2/12 "
- 2/19 "
- 2/26 "
- 3/10 "
- 3/18 TD 4120'  
D&A

**ABANDONED**



County Jewell State Kansas

Sec. 19 (Blk. Twp.) 1 (Sur. Rge.) 7W Map No.

Operator National Assoc. Pet.

Well No. 1 Farm Glen Roe

Elev. 1725 Location NE NE NE

							0

330 Ft. From N Line NE

330 Ft. From E Line Quarter

1st. Report

Completion MAR 18 1953


Remarks Wildcat

Spudding Date

Drig. Data

TD 4120 D & A

APR 10 1953

 

J. G. McGEHEE